

SECTION

LAND CORNER RECORDATION CERTIFICATE
Filing Requirement of Act 74, Mich. P.A., 1970

For corners in
MONROE (58)
(County)

Located In: ERIE TWP. Corner Code # E-8
T B S R & E
S T R
S T R
S T R
S T R

- 1. Public Land Survey
- 2. Property Controlling in Section
- 3. Miscellaneous Property in Sec.
- 4. Lot No. _____, Recorded Plat _____
- 5. Private Claims _____

RECEIVED FOR RECORD
99 DEC 29 AM 8:52
REGISTER OF DEEDS
MONROE COUNTY, MICH

1999 Remonumentation Program Corner

I, George B. Warnke, Jr., in a field survey on May - September, 1999 do hereby state that under requirements of P.A. 74, Michigan P.A. of 1970, the corner points mentioned in lines 1 and 2 above were in conformance with regulations and rules therefore as required in the current manual of survey instructions of the United States Department of the Interior, Bureau of Land Management or by decree of a Court of Law and / or that the corner points mentioned in lines 3, 4 and 5 above were in conformance with the rules of the Michigan Board of Land Surveyors or by a Decree of a Court of Law; established, re-established, monumented, recovered, found as expressed below:


Register of Deeds Stamp & File Number

NOTE: Not more than 2 corners, all in the same town and range, may be recorded on this certificate.

A. Description of original monument and accessories and/or subsequent restoration:

1820 / GLO / Joseph Wampler / North Between Secs. 20 & 21 - 40.00 Set qr. Sec. post -
B. Oak 15 ins. dia. S69E 330 lks - No other bearing trees
Year? / Thos. A. Steiner / Copy of Minutes of Survey (from old book) / notes corner "Found in Middle of Road"

- 5-1948 / Marino / field notes / F. WD. PLUG
- 4-1954 / A. J. Marino / field notes / found old wood hub in asphalt
- 8-1954 / A. J. Marino / field notes / found old wood hub
- 4-1960 / A. J. Marino / field notes / F. R.R. Spike
- 5-1962 / A. J. Marino / field notes / R.R. Spike
- 3-1966 / A. J. Marino / field notes / F. R.R. Spike
- 3-1967 / A. J. Marino / field notes / F. R.R. Spike
- 4-1967 / A. J. Marino / field notes / F. R.R. Spike

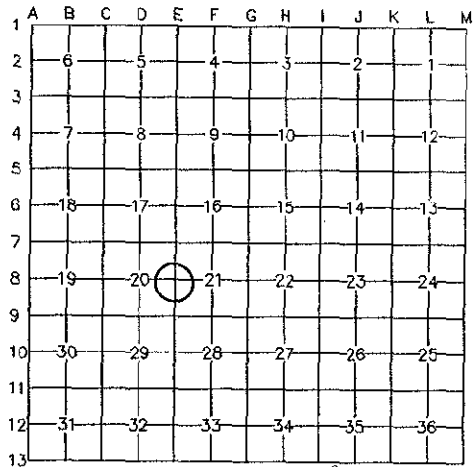

1975 / Case & Fleck / Boundary #19098 / FD. R.R. SPIKE

3-1976 / G. B. Warnke / Boundary #76-36 / I. Bolt over R.R. Iron - witnesses:
N45°W 34.23' NE corner conc. headwall & S40°W 32.97' NE corner conc. headwall & S40°E 45.95' nail east face tel. pole

6-1977 / G. B. Warnke / LCRC, Liber 2, Page 222 / I. Bolt over R.R. Iron / same 3 witnesses as GBW 1976

3-1979 / G. B. Warnke / Boundary #79-34 / I. Bolt over R.R. Iron / same 3 witnesses as GBW 1976

4-1979 / G. B. Warnke / Boundary #79-54 recorded in Liber 799, Page 705 / I. Bolt over R.R. Iron / same 3 witnesses as GBW 1976

8-1979 / A. J. Marino / field notes / FI

11-1982 / G. B. Warnke / Boundary #82-164 / I. Bolt over R.R. Iron / same 3 witnesses as GBW 1976

3-1990 / J. C. Andrus / Boundary #90S-5813 / Existing Iron Pin / same 3 witnesses as GBW 1976

12-1995 / G. B. Warnke / Boundary 95-0040 / Found 1" Railroad Bolt / witnesses:
S40°W 40.46' fd nail / shiner NW face elec. pole & S30°E 45.97' fd nail/ car coin NE face cable pole &
S80°E 72.80' fd railroad spike W face 36" Maple & N40°W 48.10' fd nail/ car coin SE face U.P.

Year? / A. J. Marino files / witness sheet / corner material not noted / witnesses
26" Maple S55E 46.60 & 30" Maple S69E 74.52 & 32" Maple S72E 103.52

B. Description of corner evidence found and/or method applied in restoring or re-establishing corner:

Corner is located at intersection of Substation road & Suder avenue - 3" tarby over 3" gravel over 18" heavy stone.
5/26/99 - Dug 2' diameter x 30" hole. Railroad bolt at surface. Used 3' offset east & north. Found small 0.2 x 0.2 railroad rail on end 8" deep the center is 0.1 to east. Found pieces of pottery, clay pots, green glass & pieces of brick at 15 - 24" deep around vertical rail. Found 1" x 2" x 12" stake drove in top of 1" diameter pipe against west edge of rail with top of pipe about 20" deep. Probed to 42" deep with no further evidence found. Could wood hub have been found by A.J. Marino crews in 1948 & 1954? - probably! Placed pottery, etc. around base of rail. Note the railroad crossing bolt would have been over wood stake in 1" pipe. Set monument box at surface in pavement.
9/21/99 - set brass remonumentation cap on 1/2" rebar in 1" pipe at west edge of flange of rail in set monument box

RATIFIED BY PEER GROUP, PA 345 OF 1990, MONROE COUNTY, MICHIGAN, DATE 7/13/1999, COUNTY REP. [Signature]
Corner is accepted as the best available evidence of the position of the original corner.

C. Description of monument for corner and accessories established to perpetuate locating the position of the corner:

Set brass remonumentation cap on 1/2" rebar in 1" pipe at west edge of flange of rail in set monument box - Witnesses:
South 70° East 72.75 feet to railroad spike in west face of 36" Maple
South 69° East 74.63 feet to nail & shiner in northeast face same tree (74.52') MSHD? (74.68 feet to R.R. bolt)
South 50° East 45.94 feet to nail & aluminum car coin in northeast face of telephone pole (45.95 feet to R.R. bolt)
South 40° West 40.52 feet to double head nail & remon. shiner in northwest face of electric pole (40.50 feet to R.R. bolt)
North 35° West 49.82 feet to double head nail & remon. shiner in northeast face of electric pole M B-83 (49.80 feet to R.R. bolt)
East 3-1/2 feet to centerline of pavement +/- on centerline of Substation Road

Signed by [Signature]
Surveyor's Michigan License No. 19474



Date September 23, 1999

FORM APPROVED BY MICHIGAN STATE BOARD OF LAND SURVEYORS, JAN. 28, 1971
REVISED MAY 14, 1975
REVISED JAN., 1983
REVISED OCT., 1994