

SECTION

LAND CORNER RECORDATION CERTIFICATE
Filing Requirement of Act 74, Mich. P.A., 1970

For corners in
MONROE (58)
(County)

- 1. Public Land Survey
- 2. Property Controlling in Section
- 3. Miscellaneous Property in Sec.
- 4. Lot No. _____, Recorded Plat _____
- 5. Private Claims _____

Located In: ERIE TWP.
T 8 S R 8 E
Corner Code # E-9

S _____ T _____ R _____
S _____ T _____ R _____
S _____ T _____ R _____
S _____ T _____ R _____

RECEIVED FOR RECORD
 99 DEC 28 AM 8:53
 Register of Deeds
 MONROE COUNTY, MICH.


1999 Remonumentation Program Corner

I, George B. Warnke, Jr., in a field survey on 5/26/99 - 9/21/99 do hereby state that under requirements of P.A. 74, Michigan P.A. of 1970, the corner points mentioned in lines 1 and 2 above were in conformance with regulations and rules therefore as required in the current manual of survey instructions of the United States Department of the Interior, Bureau of Land Management or by decree of a Court of Law and / or that the corner points mentioned in lines 3, 4 and 5 above were in conformance with the rules of the Michigan Board of Land Surveyors or by a Decree of a Court of Law; established, re-established, monumented, recovered, found as expressed below:

NOTE: Not more than 2 corners, all in the same town and range, may be recorded on this certificate.

A. Description of original monument and accessories and/or subsequent restoration:

- 1820 / GLO / Joseph Wampler / 80.00 - Set post corner of Secs. 20, 21, 28 & 29 from which a Beach 34 ins. dia. bears N38E 7.39 lks. dis. & a Hickory 11 ins. dia. bears S4E 5.69 lks. dis.
- 1947 / A.J. Marino / field notes / valve / NW'ly 39.73' conc. wings of culvert & SW'ly 43.0' conc. wings of culvert & SE'ly 51.4' to 1 1/2" Pipe
- 1948 / A.J. Marino / field notes / F. R.R. Iron
- 1953 / A.J. Marino / field notes / F. I. Rod / NE'ly 40.31 NW'ly corner headwall & SE'ly 41.0 SW'ly corner headwall & SW'ly 40.6 SE'ly corner headwall
- 1954 / A.J. Marino / field notes / Found Iron
- 1957 / A. J. Marino / field notes / F.I.
- 1958 / A. J. Marino / field notes / F.I.
- 1960 / A. J. Marino / field notes / F.I. Rod
- 1962 / A. J. Marino / field notes / F.I. / shows N'ly on Suder Ave. 2616.18' - M to R.R. Spike @ W1/4 Cor. Sec. 21 [E-8] E'ly 2632.60' to Mon. @ S1/4 Cor. Sec. 21 [F-9]
- 1967 / A. J. Marino / field notes / F.I.
- 1971 / A. J. Marino / field notes / F. Iron
- 1975 / Hooth & Miller with State / LCRC, Liber 2, Page 78 / Railroad Iron in intersection / N65°E 45.64' NE corner of headwall & S50°E 35.29' Tele. Pole & S75°W 52.50' Chiseled X on rim of catch basin & N45°W 45.03' Power Pole
- 1976 / G.B. Warnke / Boundary #76-36 / R.R. Iron
N65°E 45.64' NE corner of headwall & S50°E 35.90' M.S.H.D. shiner S. face tel. pole & S75°W 52.50' "+" cut on rim of catch basin
- 1979 / G.B. Warnke / Boundary #79-34 / R.R. Iron / 3 witnesses match GBW 19976
- 1986 / G.B. Warnke / #86-460 / Found R. R. Iron (recorded: LCRC - Lib. 2, Pg. 78)
- 1990 / G. B. Warnke / Boundary #90-180 / R.R. Iron / N45°W 45.03' nail in S1/4 (S'ly?) face of elec. pole & S50°E 34.05' set nail/shiner N side T Pole & S45°E 105.05' NW cor. Brick house porch & N20°E 112.89' set nail SE side T Pole
- 1993 / J.C. Andrus / Boundary #93s-6912 / Found Rail / N4°W 44.40' to nail in P. Pole & N70°E 34.31' to stop sign & S50°E 34.85' to nail in T. Pole & S50°W 28.32' to stop sign

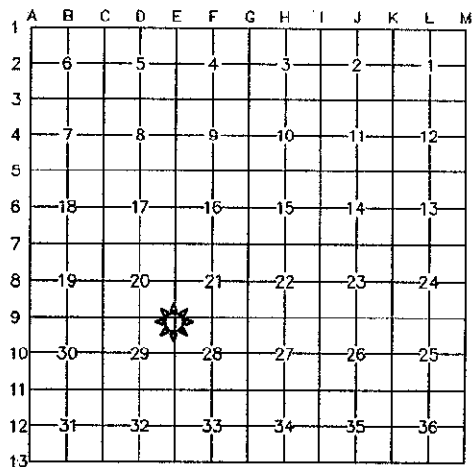

B. Description of corner evidence found and/or method applied in restoring or re-establishing corner:

Corner is located at the intersection of Dean Road & Suder Avenue in 4" asphalt over 4" gravel over 16" heavy stone.
5/26/99 - Found 0.2 x 02 light rail with "+". Dug 2' diameter x 30" hole and found round top stone 0.6 x 0.4 at the southeast corner of rail at 1' deep. Pieces of stake or wood along west edge approximately 15" long also found. Pieces of brick, pottery, blue glass found around base of (about 15" deep) R.R. rail. Estimate rail to be at least 4' long. Witnessed "+" on rail & replaced brick, pottery, etc. around rail in bottom of hole. Drove 1" iron rod on west edge of rail. Rail was flush with pavement & drove it down 6" below pavement. Set monument box over/around rail. 9/21/99 - wired yellow plastic remonumentation cap on RR iron / use "+" cut in rail.

RATIFIED BY PEER GROUP, PA 345 OF 1990, MONROE COUNTY, MICHIGAN, DATE 7/13/1999, COUNTY REP. [Signature]
Corner is accepted as the best available evidence of the position of the original corner.

C. Description of monument for corner and accessories established to perpetuate locating the position of the corner:

- Wired yellow remonumentation cap on RR iron / use "+" cut in rail in set monument box & Witnesses:
- South 75° West 52.50 feet to "+" cut on east rim of concrete catch basin & North 70° East 34.00 feet to south edge of stop sign post
- South 70° West 35.88 feet to north edge of stop sign post & South 50° East 47.83 feet to northwest face of cast iron rim
- North 45° West 45.00 feet to double head nail & shiner in southwest face of electric pole
- South 50° East 35.00 feet to found nail & shiner in north face of telephone pole

Signed by [Signature]
Surveyor's Michigan License No. 19474



Date October 26, 1999

APPROVED BY MICHIGAN STATE BOARD OF LAND SURVEYORS, JAN. 28, 1971
REVISED MAY 14, 1975
REVISED JAN., 1983
REVISED OCT., 1994