

**SURVEY &
REMONUMENTATION**

APR 28 1995

COMMISSION

LAND CORNER RECORDATION CERTIFICATE
Filing Requirement of Act 74, Mich. P.A. 1970

RECEIVED FOR RECORD

94 DEC 29 AM 11:11

Hersi Allen
REGISTER OF DEEDS
MONROE COUNTY, MICH

RATIFIED BY PEER GROUP
PA 345 OF 1990
MONROE COUNTY, MICHIGAN
date: 11/22/1994
County Rep.: [Signature]
For corners in MONROE
(County)

Located in: ERIE TWP. Corner Code ##

1. Public Land Survey	T <u>8</u> S <u>R 8</u> E	<u>E-11</u>
	T _____ R _____	_____
	T _____ R _____	_____
	T _____ R _____	_____
2. Property Controlling in Section	S _____ T _____ R _____	_____
	S _____ T _____ R _____	_____
3. Miscellaneous Property in Sec.	S _____ T _____ R _____	_____
	S _____ T _____ R _____	_____

Register of Deeds Stamp & File Number


4. Lot No. _____, Recorded Plat _____
5. Private Claims _____

1994 MONROE COUNTY REMONUMENTATION PROGRAM

Peer Group approved corner on 11/22/1994 per Act 345 of 1990.

I, G.B. WARNKE, JR., in a field survey on 12/9/1994, 19_____, do hereby certify that under requirements of P.A. 74, Michigan P.A. of 1970, the corner points mentioned in lines 1 and 2 above were in conformance with regulations and rules therefore as required in the current manual of survey instructions of the United States Department of the Interior, Bureau of Land Management or by a decree of a Court of Law and/or that the corner points mentioned in lines 3, 4 and 5 above were in conformance with the rules of the Michigan Board of Land Surveyors or by a Decree of a Court of Law; established, re-established, monumented, re-monumented, recovered, found as expressed below:

NOTE: Not more than 4 corners, all in the same town and range, may be recorded on this certificate.

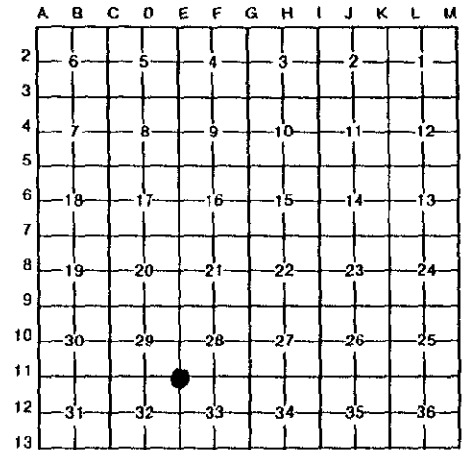

A. Description of original monument and accessories and/or subsequent restoration:

E-11, T8S, R8E, Erie Township, Monroe County - ID No. 58 Section Corner Common to Sections 28, 29, 32 and 33 (Suler Avenue and Sterns Road - tar chip 3 inches, clay & stone mix 8 inches, clay) 1820, G.I.O. Surveyor, Joseph Wampler, set post cor. of Secs. 28, 29, 32 & 33: B. Oak 20 (inch) N.38°W. 399 lks & Aspen 11 (inch) N.74°W. 265 lks. ~~reference to CLO 1927 by Clark unknown~~ Old little book references Bk 1, Pg 17, map shows distance 2548 feet to west from T. & OB R.R. to stone at NW cor. of Sec. 33 - surveyor(?). 1914, The Adeline Plat by C.S. McKee & surveys in 1948 by A.J. Marino & 1949 by Lankauf use corner with no material reference. A.J. Marino: 1953 notes found wood; 1955 - F.I.P; 1956 - bolt in pav't. 1956 Willow Point Sub'd by M.R. Fleck & 1959 Ray Mar Addition plat by V. Farnham began at corner. 1977, Assessor's Plat to Morin Grove to R.R. iron. 1973, G.B. Warnke used vertical R.R. iron. 1975, LCRC, Liber 2, Pg 80, by Ervin Miller used R.R. iron. 1978, Fleck used I.P. 1988, LCRC, Liber 3, Pg 137, by Gary Bilow to capped iron pipe.

B. Description of corner evidence found and/or method applied in restoring or reestablishing corner:

E-11 - 11/21/1994, found 3/4 inch x 5 inch pipe over small railroad rail (vertical). Found 1/2 inch square bolt 0.14 feet north and 0.14 feet west of iron pipe and rail. Bolt was between two 1 inch X 3 inch wood hubs. Dug an 18 inch X 36 inch hole at 14 inches found large dark granite stone being 0.50 feet east and 0.10 feet north (to high point) of iron pipe and track. Could not remove stone or rail. Did not set anything at this time. 12/9/1994, set 1 inch x 36 inch iron pipe, inside crotch of rail, with remonumentation cap inside monument box to replace iron pipe over rail.

C. Description of monument for corner and accessories established to perpetuate locating the position of the corner:

E-11 - Set 1 inch x 36 inch iron pipe with brass remonumentation cap inside monument box to replace found 3/4 inch x 5 inch pipe over small railroad rail and is accepted as the best available evidence of the position of the original and Witnesses:

- North 35° East 35.39 feet to found nail/shiner in telephone pole
- South 45° West 39.56 feet to found nail/shiner in power pole
- North 65° West 76.77 feet to found nail/shiner in telephone pole
- South 20° East 81.83 feet to telephone pole



Signed by [Signature]
Surveyor's Michigan License No. 19474

Date 12/9/1994