

LAND CORNER RECORDATION CERTIFICATE
Filing Requirement of Act 74, Mich. P.A., 1970

SECTION _____

For corners in
MONROE (58)

	Located In:	Corner Code #
(County)	ERIE TWP.	
1. Public Land Survey	T 8 S R 8 E	<u>G-6</u>
	T _____ R _____	_____
2. Property Controlling in Section	S _____ T _____ R _____	_____
	S _____ T _____ R _____	_____
3. Miscellaneous Property in Sec.	S _____ T _____ R _____	_____
	S _____ T _____ R _____	_____
4. Lot No. _____, Recorded Plat _____		
5. Private Claims _____		

RECEIVED FOR RECORD
 99 DEC 28 AM 8:56
 REGISTER OF DEEDS
 MONROE COUNTY, MICH.
George B. Warnke, Jr.


Register of Deeds Stamp & File Number

1999 Remonumentation Program Corner

I, George B. Warnke, Jr., in a field survey on September, 1999, do hereby state that under requirements of P.A. 74, Michigan P.A. of 1970, the corner points mentioned in lines 1 and 2 above were in conformance with regulations and rules therefore as required in the current manual of survey instructions of the United States Department of the Interior, Bureau of Land Management or by decree of a Court of Law and / or that the corner points mentioned in lines 3, 4 and 5 above were in conformance with the rules of the Michigan Board of Land Surveyors or by a Decree of a Court of Law; established, re-established, monumented, recovered, found as expressed below:

NOTE: Not more than 2 corners, all in the same town and range, may be recorded on this certificate.

A. Description of original monument and accessories and/or subsequent restoration:
 1820 - GLO Joseph Wampler - North / Between Secs. No. 15 & 16 / 40.00 / Set the 1/2 mile post from which a B. Oak 30 ins. dia. bears S14E 13.19 lks. dis. / no other timber near
 1916 - J. W. White - Home Orchards plat, Liber 3, Pages 46 & 47 - Stone
 year? - surveyor? - copy of witness sheet found files - 1/2" iron rod -
 nails in: 14" Maple NW 47.25 & 14" Maple SE 39.45 & 10" Maple NE 46.85
 9/1960 - Raymond Graf - witness card - 1/2" iron rod -
 NE cor. of house N27°W 109.43 & SE cor of said house N38°W 84.65 &
 16" Maple N49°W 47.25' & 10" Maple N24°E 66.07' & 15" Maple N34°E 46.76' &
 13" Maple N54°E 30.57' & 12" Maple S84°E 48.62'
 3/1967 - A. J. Marino - notes - F.I.
 8/1972 - A. J. Marino - notes - F.I.R.
 12/1972 - A. J. Marino - notes - F 1/2" solid iron - it seems to fit M.D.S.H. witnesses
 7/1973 - G. B. Warnke - Job #73-50 - Liber 654, Page 860 - Set bolt over stone fd. 1' dp. -
 N54°W 50.70' Fd nail SW face 16" Maple & N40°W 87.23' SE cor. res'd foundation & N47°E 26.52' nail W face 14" Maple
 2/1975 - A. J. Marino - notes - F.I.R.
 1/1991 - G. B. Warnke - LCRC, Liber 3, Page 168 (ref. 91-0002) - found stone 1' deep under leaning railroad bolt & re-set 9" railroad bolt over high point of stone - N10°E 25.76' set PK / shiner E. side guy pole & N45°W 43.55' set PK NE side Util. pole & N40°W 87.31' SE corner Fndt. H.N 3200 & S50°W 36.33' SW corner Conc. headwall & N20°E 107.38' SW corner frame barn & S81°20'W 5.18' fd. 1/2" iron pin used by M.S.H.D. - 1951

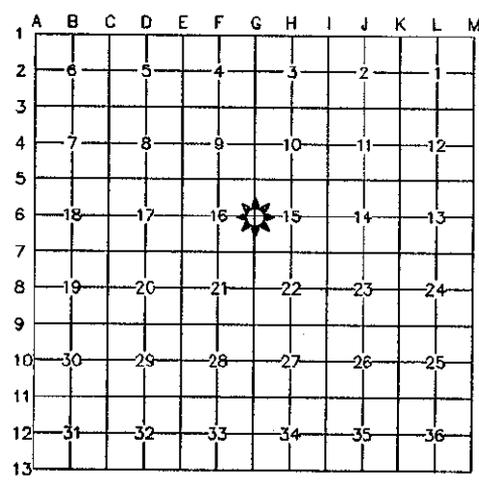

B. Description of corner evidence found and/or method applied in restoring or re-establishing corner:
 Corner is located at the intersection of Vienna (W) & Bay Creek (N-S) roads in asphalt pavement.
 9/23/1999 - found small nail in newer asphalt. Bolt was gone from earlier surveys. Found 2 railroad spikes laying against stone. Recovered sandstone at 16" to high point - 10" tall x 5" x 5". No post found. Dug hole to 32" deep. Set 1/2" x 18" rebar in bottom. Set 1" x 36" pipe with set brass remonumentation cap. Placed pieces of sandstone around base of pipe. Also placed pieces of brick above sandstone. Set monument box.

RATIFIED BY PEER GROUP, PA 345 OF 1990, MONROE COUNTY, MICHIGAN, DATE 7/13/1999, COUNTY REP. *[Signature]*
 Corner is accepted as the best available evidence of the position of the original corner.

C. Description of monument for corner and accessories established to perpetuate locating the position of the corner:
 Set 1" x 36" iron pipe with set brass remonumentation cap in set monument box & Witnesses:
 N10°E 25.76' PK / shiner E. side guy pole
 N45°W 43.55' PK NE side Util. pole
 N40°W 87.31' SE corner Fndt. H.N 3200
 S50°W 36.33' SW corner Conc. headwall
 N20°E 107.38' SW corner frame barn
 S81°20'W 5.18' fd. 1/2" iron pin used by M.S.H.D. - 1951

Signed by *[Signature]*
 Surveyor's Michigan License No. 19474



Date October 26, 1999

APPROVED BY MICHIGAN STATE BOARD OF LAND SURVEYORS, JAN. 28, 1971
 REVISED MAY 14, 1975
 REVISED JAN., 1983
 REVISED OCT., 1994