

MAY 20 1997

COMMISSION

LAND CORNER RECORDATION CERTIFICATE
Filing Requirement of Act 74, Mich. P.A., 1970

RECEIVED FOR RECORD

96 DEC 13 PM 3:23

Bruce Antcliff
REGISTERED LAND SURVEYOR
No. 25826

For corners in

<u>Monroe</u> (County)	Located In:	Corner Code #
	<u>Erie Twp.</u>	
1. Public Land Survey	T <u>8S</u> R <u>8E</u>	<u>G-7</u>
	T _____ R _____	_____
	T _____ R _____	_____
	T _____ R _____	_____
2. Property Controlling in Section	S _____ T _____ R _____	_____
	S _____ T _____ R _____	_____
3. Miscellaneous Property in Sec.	S _____ T _____ R _____	_____
	S _____ T _____ R _____	_____

Register of Deeds Stamp & File Number

4. Lot No. _____, Recorded Plat _____

5. Private Claims _____

I, Bruce Antcliff, in a field survey on February, 1996 do hereby state that under requirements of P.A. 74, Michigan P.A. of 1970, the corner points mentioned in lines 1 and 2 above were in conformance with regulations and rules therefore as required in the current manual of survey instructions of the United States Department of the Interior, Bureau of Land Management or by decree of a Court of Law and / or that the corner points mentioned in lines 3, 4 and 5 above were in conformance with the rules of the Michigan Board of Land Surveyors or by a Decree of a Court of Law; established, re-established, monumented, recovered, found as expressed below:

NOTE: Not more than 2 corners, all in the same town and range, may be recorded on this certificate.

Monroe County Road Commission Corner

A. Description of original monument and accessories and/or subsequent restoration:

Section corner common to Sections 15, 16, 21 & 22, T8S, R8E / Bay Creek Road, currently gravel, will be paved. 1820 GLO Surveyor Wampler set wood post, W.O.9" N46W, 9.36 links

1951 3/4" Iron Pipe, source of witnesses unknown; 10" Basswood, S32E, 53.89'; 2" Juniper, S48E, 39.37'; 12" Cherry, S61E, 55.51'; 9" Cherry, S69E, 74.30'; NW Cor. Hse., S60-30E, 90.23'

1973 to 1976 M.R.Fleck reports a boat spike over stone; Nail in Tree, S30E, 53.68'; Nail in P.Pole, N70E, 29.00'; Nail in P. Pole, N35W, 46.40'

April, 1995 Dave Andrus found RR Spike, same witnesses as M.R.Fleck above.

B. Description of corner evidence found and/or method applied in restoring or re-establishing corner:

Excavated corner at location of found boat spike. Boat spike was at a depth of 6". At a depth of 15" found 3/4" iron pipe 0.12' S. and 0.08'E of boat spike. Also found stone at a depth of 15", high point being 0.24'S and 0.22'E of boat spike.


C. Description of monument for corner and accessories established to perpetuate locating the position of the corner:

Set 1" x 36" iron pipe with brass remonumentation cap inside monument box to replace boat spike and is accepted as the best evidence of the position of the original corner.

Witnesses:

- N81E, 28.43', PK Nail/Shiner South Face of Power Pole
- S67E, 85.97', Chiseled "+" in SW face of well casing located 15' North of Hse. #9066
- S58E, 90.23', NW Corner of Hse. #9066
- S18E, 76.34', 60d Nail/DNR Tag in SW face of 30" Tree
- S34W, 48.74', 60d Nail/DNR Tag in SE face of Power Pole.

RATIFIED BY PEER GROUP
PA 345 OF 1990
MONROE COUNTY, MICHIGAN
date: 8/27/1996
County Rep.: *[Signature]*

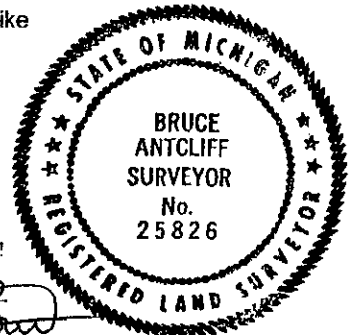

Signed by *Bruce Antcliff*

Date 11-13-96

Surveyor's Michigan License No. 25826

