

SURVEY & REMONUMENTATION

FEB 13 1998

SECTION

LAND CORNER RECORDATION CERTIFICATE Filing Requirement of Act 74, Mich. P.A., 1970

For corners in

Monroe (58)	Located In:	Corner Code #
(County)	ERIE TWP.	
1. Public Land Survey	T8S R8E	I-3
	T ___ R ___	_____
	T ___ R ___	_____
	T ___ R ___	_____
2. Property Controlling in Section	S ___ T ___ R ___	_____
	S ___ T ___ R ___	_____
3. Miscellaneous Property in Sec.	S ___ T ___ R ___	_____
	S ___ T ___ R ___	_____
4. Lot No. _____, Recorded Plat _____		
5. Private Claims _____		

RECEIVED FOR RECORD
 97 DEC 30 PM 3:47
George B. Warnke
 REGISTER OF DEEDS
 MONROE COUNTY, MICH.

Register of Deeds Stamp & File Number

1997 G.B. Warnke Private Corner

I, George B. Warnke, Jr., in a field survey on September - December, 1997 do hereby state that under requirements of P.A. 74, Michigan P.A. of 1970, the corner points mentioned in lines 1 and 2 above were in conformance with regulations and rules therefore as required in the current manual of survey instructions of the United States Department of the Interior, Bureau of Land Management or by decree of a Court of Law and / or that the corner points mentioned in lines 3, 4 and 5 above were in conformance with the rules of the Michigan Board of Land Surveyors or by a Decree of a Court of Law; established, re-established, monumented, recovered, found as expressed below:

1	A	B	C	D	E	F	G	H	I	J	K	L
2	6	5	4	3	2	1						
3									●			
4	7	8	9	10	11	12						
5												
6	18	17	16	15	14	13						
7												
8	19	20	21	22	23	24						
9												
10	30	29	28	27	26	25						
11												
12	31	32	33	34	35	36						
13												

NOTE: Not more than 2 corners, all in the same town and range, may be recorded on this certificate.

- A. Description of original monument and accessories and/or subsequent restoration:
- 1820 GLO, Joseph Wampler, set post corner of Secs. 2, 3, 10 & 11 from which a Hickory 16 ins. dia. bears S80W 26 lks. dis. & a Hickory 14 ins. dia. bears 41E 19 lks dis.
 - 1950 A.J. Marino notes & survey - used corner - no material noted
 - 1950? A.J. Marino files - railroad spike in pavement
 - 1950? A.J. Marino files - railroad spike
 - 1952 A.J. Marino notes - R.R. spike
 - 1959 Case & Fleck survey - Mon.
 - 1960? A.J. Marino notes - F. Mon.
 - 1962 A.J. Marino survey - notes corner - no material noted & A.J. Marino notes - Mon.
 - 1963 A.J. Marino survey - notes corner - no material noted
Case & Fleck survey - Mon. & A.J. Marino notes - Mon. & A.J. Marino notes - F.I.
 - 1965 A.J. Marino notes & survey - notes corner - no material noted & A.J. Marino notes - Mon.
 - 1966 A.J. Marino notes - Mon.
 - 1966 Consumers' Power survey - notes corner - not material noted
 - 1968 William Roskelly, Basney & Smith, survey - notes corner - no material noted
 - 1987 G.B. Warnke survey - iron pin in mon box
 - 1988 G.B. Warnke survey - iron pin in monument box
 - 1989 G.B. Warnke LCRC, Liber 3, Page 58 & survey - iron pin in monument box
 - 1995 G.B. Warnke survey - found 1/2" rebar in monument box


B. Description of corner evidence found and/or method applied in restoring or re-establishing corner:
 9/17/1997, G.B. Warnke found pin in monument box (top missing) located 50-60' east of beginning of westerly ramp to bridge over I-75

RATIFIED BY PEER GROUP, PA 345 OF 1990, MONROE COUNTY, MICHIGAN, DATE 11/18/1997, COUNTY REP. *[Signature]*

12/15/1997, G.B. Warnke crew set brass remonumentation cap on found pin in monument box.

- C. Description of monument for corner and accessories established to perpetuate locating the position of the corner:
 Set brass remonumentation cap on found pin in monument box and is accepted as the best available evidence of the position of the original corner. Witnesses:
 North 45 West 68.10' to 2' pipeline marker
 South 80 West 163.58' to nail in northerly face of light pole
 North 85 East 217.57' to nail in top westerly guard post
 South 85 East 221.13' to nail in top easterly guard post

Signed by *[Signature]*
 Surveyor's Michigan License No. 19474

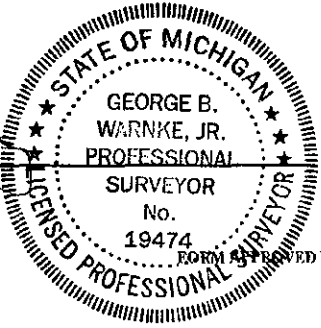

Date December 16, 1997