

ATIFIED BY PEER GROUP  
 PA 345 OF 1990  
 MONROE COUNTY, MICHIGAN  
 date: 10/25/94  
 County Rep.: [Signature]

LAND CORNER RECORDATION CERTIFICATE  
 Filing Requirement of Act 74, Mich. P.A. 1970

RECEIVED FOR RECORDS  
 95 DEC 28 AM 8:59  
 REGISTER OF DEEDS  
 MONROE COUNTY, MICHIGAN

For corners in

<u>Monroe</u> (County)	Located In:	Corner Code #
1. Public Land Survey Whiteford Twp.	T <u>  </u> R <u>  </u> T <u>9S</u> R <u>6E</u>	<u>C-1</u>
2. Property Controlling in Section	T <u>  </u> R <u>  </u> T <u>  </u> R <u>  </u>	<u>SURVEY &amp; REMONUMENTATION</u>
3. Miscellaneous Property in Sec.	S <u>  </u> T <u>  </u> R <u>  </u> S <u>  </u> T <u>  </u> R <u>  </u> S <u>  </u> T <u>  </u> R <u>  </u>	<u>APR 04 1996</u>
4. Lot No. <u>      </u> , Recorded Plat <u>      </u>		<u>COMMISSION</u>
5. Private Claims <u>      </u>		

Register of Deeds Stamp & File Number

G.B. Warnke & Monroe Co. Road Commission Corner  
 Bruce Antcliff 12/20 95  
 I, G.B. Warnke, in a field survey on Sept, 1994, do hereby state that under requirements of P.A. 74, Michigan P.A. of 1970, the corner points mentioned in lines 1 and 2 above were in conformance with regulations and rules therefore as required in the current manual of survey instructions of the United States Department of the Interior, Bureau of Land Management or by a decree of a Court of Law and for that the corner points mentioned in lines 3, 4 and 5 above were in conformance with the rules of the Michigan Board of Land Surveyors or by a Decree of a Court of Law, established, re-established, monumented, recovered, found as expressed below:


NOTE: Not more than 2 corners, all in the same town and range, may be recorded on this certificate.

	A	B	C	D	E	F	G	H	I	J	K	L	M
1													
2	6		5		4		3		2		1		
3													
4	7		8		9		10		11		12		
5													
6	18		17		16		15		14		13		
7													
8	19		20		21		22		23		24		
9													
10	30		29		28		27		26		25		
11													
12	31		32		33		34		35		36		
13													

A. Description of original monument and accessories and/or subsequent restoration:  
 Section Corner common to Sections 5 & 6, T9S, R6E / In Yankee Road, asphalt over stone/  
 1820 GLO Surveyor Joseph Wampler set post, no notes to distance west of corner in T8S, R6E  
 Witnessed: Sugar 14 inch South 18° West 9 links, Sugar 11 inch North 17° East 21 links. 1945  
 survey A.J. Marino notes not found, evidence of corner unknown. 1968 Dana survey by J. Weithman  
 probably used P.K. nail. About 1992 David Andrus (J.C.A.) Found P.K. nail 0.3 feet deep, set RR spike.

B. Description of corner evidence found and/or method applied in restoring or reestablishing corner:  
 9/1994, Recovered RR spike over P.K. nail. Dug 20 inch x 36 inch hole and probed, no evidence  
 of stone or post. Set 1 inch x 36 iron pipe and witnessed as shown below.

C. Description of monument for corner and accessories established to perpetuate locating the position of the corner:  
 Set 1 inch x 36 inch iron pipe with brass remonumentation cap inside monument box to replace RR spike and P.K. nail  
 and is accepted as the best available evidence of the position of the original corner.  
 Witnesses:  
 North 25° East 103.90 feet to SW corner of 6' high brick pillar fence post.  
 North 70° East 101.85 feet to SW corner of 6' high brick pillar fence post.  
 South 50° East 60.33 feet to nail/shiner in NW face of tel. pole.  
 South 40° West 58.94 feet to nail/shiner in NE face of power pole.

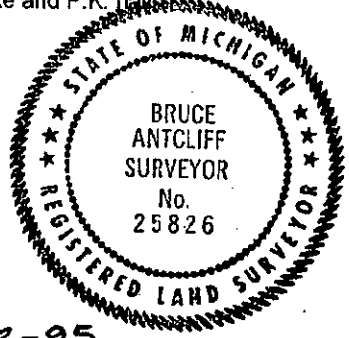

Signed by Bruce Antcliff  
 Surveyor's Michigan License No. 25826

Date 12-22-95

③ C-1 T9S, R6E, WHITEFORD LIBRA 4 Pabl 50