

SURVEY & REMONUMENTATION

AUG 19 1996


State Line Post #59 = "other" code #1 COMMISSION
 " " " #60 = " " " #2
 " " " #61 = " " " #3
 " " " #62 = " " " #4
 " " " #65 = " " " #5

Map No. 8

R.C.Allen, State Geologist
Michigan Geological Survey

OHIO-MICHIGAN BOUNDARY RETRACEMENT

C.E.Sherman, Inspector
Ohio Topographic Survey

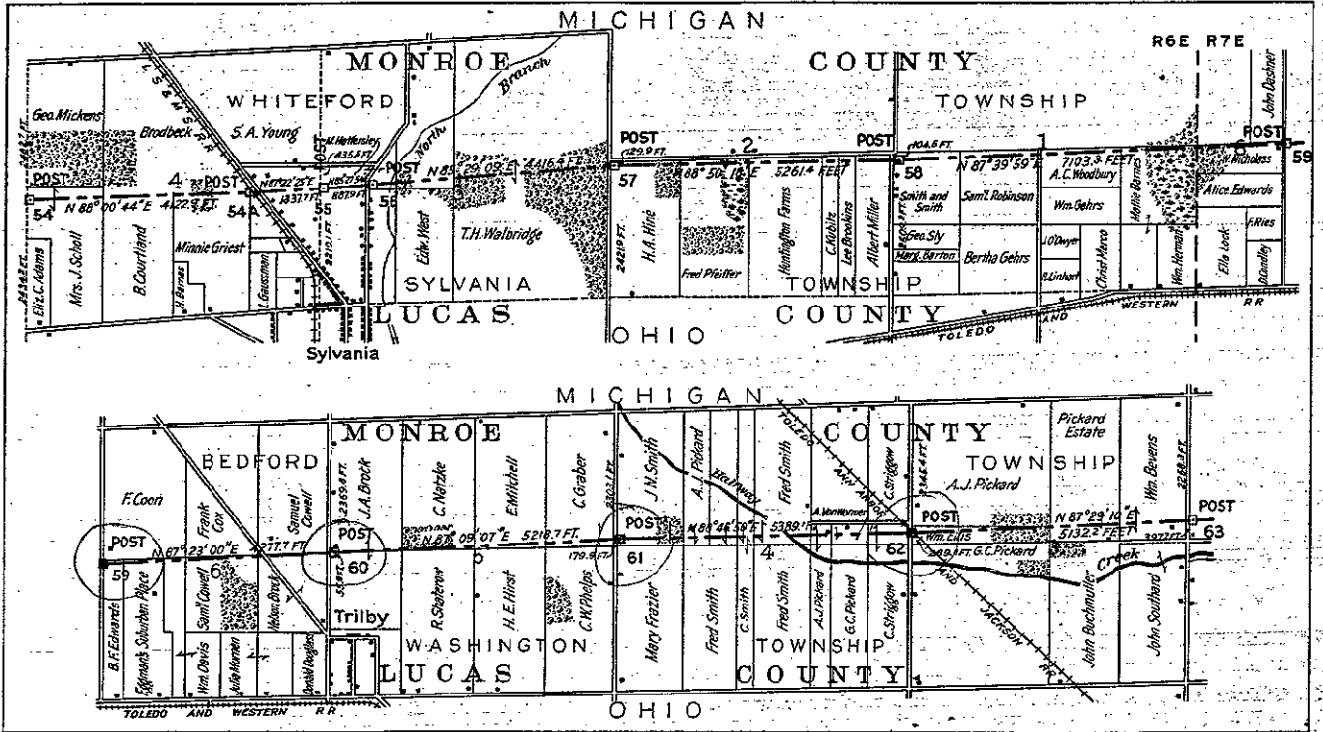

Drawn by W.D.Turnbull, C.E.
Columbus, O-1916.

Surveyed in 1915 by S.S.Gannett, Geographer
U.S. Geological Survey