

SURVEY & REMONUMENTATION

AUG 19 1996


COMMISSION

Map No. 9

R.C. Allen, State Geologist
Michigan Geological Survey

OHIO-MICHIGAN BOUNDARY RETRACEMENT

C. F. Sherman, Inspector
Ohio Topographic Survey

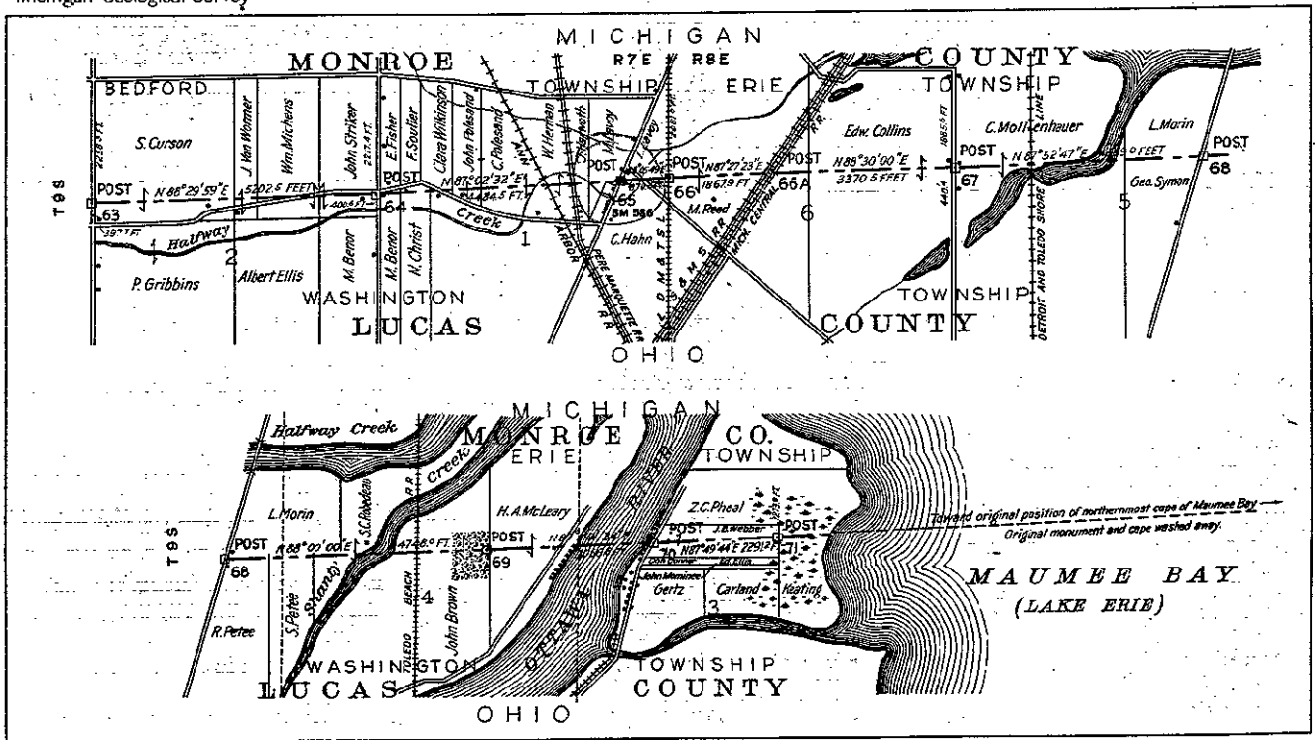

Drawn by W. D. Turnbull, C.E.
Columbus, O.-1916.

Surveyed in 1915 by S.S. Gannett, Geographer
U.S. Geological Survey