

SURVEY & REMONUMENTATION

FEB 19 1998

MONTCALM COUNTY REMONUMENTATION PROGRAM

SECTION

LAND CORNER RECORDATION CERTIFICATE

Filing Requirement of Act 74, Mich. P.A. 1970

STATE OF MICHIGAN
MONTCALM COUNTY
RECORDED

26 Dec 1997 3:41:17 PM

LORI A. WILSON
REGISTER OF DEEDS

Register of Deeds Stamp & File Number

For corners in Montcalm (County)	Located In:	Corner Code #
1. Public Land Survey	Sec 31 T 10N R 5W	A-13, SW Corner
	T 10N R 6W	M-13
	T 9N R 5W	A-1 ✓
	T 9N R 6W	M-1
2. Property Controlling in Section	S T R	
3. Miscellaneous Property in Sec.	S T R	

4. Lot No. _____, Recorded Plat _____
5. Private Claims _____

I, William Tingley a field survey on July 28, 1997, do hereby certify that under requirements of P.A. 74, Michigan P.A. of 1970, the corner points mentioned in lines 1 and 2 above were in conformance with regulations and rules therefore as required in the current manual of survey instructions of the United States Department of the Interior, Bureau of Land Management or by a decree of a Court of Law and/or that the corner points mentioned in lines 3, 4, and 5 above were in conformance with the rules of the Michigan Board of Land Surveyors or by a Decree of a Court of Law, established, re-established, monumented, re-monumented, recovered, found as expressed below:

NOTE: Not more than 4 corners, all in the same town and range, may be recorded on this certificate.

A. Description of original monument and accessories and/or subsequent restoration:
1831, Robert Clark, Jr., Deputy Surveyor, GLO Notes (On south bound sec 31 T10N-R5W)
79.21 chains intersect West boundary at end of 5.78.99
White Ash 11" N63°E 25 links
Elm 6" S20°W 26 links

R.D.McNutt cardfile
FAP no date probably 1880
stone and broken crockery
Patrick Salisbury, Consumer Power Company Survey
Found 1-1/4" pipe in Monument Box
Montcalm County Road Commission
West end Culvert Northwest 38.2 feet
Telephone Pole Northeast 74.3 feet
Road name post Southwest 34.93 feet
East end Culvert Northeast 41.8 feet

B. Description of corner evidence found and/or method applied in restoring or reestablishing corner:
Found 1-1/4" pipe in monument box
Street and Stop sign N15°E 54.55 feet
East end 12" culvert N60°W 45.41 feet
West end 12" culvert N50°E 37.87 feet
Stop sign S45°W 40.95 feet


C. Description of monument for corner and accessories established to perpetuate locating the position of the corner:

Set standard remonumentation corner over 1- 1/4" pipe in monument box.
Set nail & Tag #30104 in cut off power pole S45°E 41.63 feet
Street and Stop sign N15°E 54.55 feet
East end 12" culvert N60°W 45.41 feet
Stop sign S45°W 40.95 feet

This corner is accepted as the best available evidence of the position of the original corner.

Signed by William Tingley Date 7/30, 1997
Surveyor's Michigan License No. 30104

FORM APPROVED BY MICHIGAN STATE BOARD OF LAND SURVEYORS, JAN. 28, 1971
REVISED MAY 14, 1976
REVISED JAN., 1983
ADAPTED FOR WORD PROCESSING MARCH, 1983

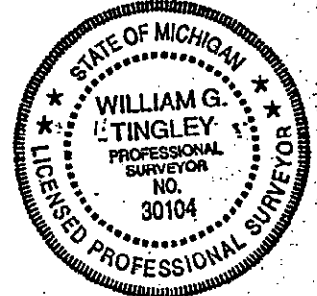

	A	B	C	D	E	F	G	H	I	J	K	L	A
1													
2	6	5	4	3	2	1							
3													
4	7	8	9	10	11	12							
5													
6	18	17	16	15	14	13							
7													
8	19	20	21	22	23	24							
9													
10	30	29	28	27	26	25							
11													
12	31	32	33	34	35	36							
13													

ACCEPTED BY THE MONTCALM COUNTY SURVEY PEER GROUP AS THE OFFICIAL CORNER UNDER MICHIGAN PUBLIC ACT 345 OF 1990 AT A MEETING HELD 7-30-97

WGT
William Tingley, PS, Chairman