

RECORDED  
MAY 07 1997  
COMMISSION

MONTCALM COUNTY REMONUMENTATION PROGRAM

LAND CORNER RECORDATION CERTIFICATE

Filing Requirement of Act 74, Mich. P.A. 1970

STATE OF MICHIGAN  
MONTCALM COUNTY  
RECORDED

For corners in  
Montcalm  
(County)

Located in:

Corner Code #

12/27/1996 2:08:12 PM

VIRGINIA L. KNEPPER  
REGISTER OF DEEDS

- 1. Public Land Survey Sec 36 T 9 N R 6 W  
Also known as — Sec 31 T 9 N R 5 W  
— Sec 1 T 8 N R 6 W  
— Sec 6 T 8 N R 5 W
- 2. Property Controlling S \_\_\_ T \_\_\_ R \_\_\_  
in Section S \_\_\_ T \_\_\_ R \_\_\_
- 3. Miscellaneous S \_\_\_ T \_\_\_ R \_\_\_  
Property in Sec. S \_\_\_ T \_\_\_ R \_\_\_

- M-13, SE Corner
- ✓ A-13, SW Corner
- M-1, NE Corner
- A-1, NW Corner
- Seg # 2

Montcalm  
Ionia

Register of Deeds Stamp & File Number

- 4. Lot No. \_\_\_\_\_, Recorded Plat \_\_\_\_\_
- 5. Private Claims \_\_\_\_\_

	A	B	C	D	E	F	G	H	I	J	K	L	M
1													
2	6	5	4	3	2	1							
3													
4	7	8	9	10	11	12							
5													
6	18	17	16	15	14	13							
7													
8	19	20	21	22	23	24							
9													
10	30	29	28	27	26	25							
11													
12	31	32	33	34	35	36							
13													

I, William Tingley a field surveyor on August 19, 1994, do hereby certify that under requirements of P.A. 74, Michigan P.A. of 1970, the corner points mentioned in lines 1 and 2 above were in conformance with regulations and rules therefore as required in the current manual of survey instructions of the United States Department of the Interior, Bureau of Land Management or by a decree of a Court of Law and/or that the corner points mentioned in lines 3, 4 and 5 above were in conformance with the rules of the Michigan Board of Land Surveyors or by a Decree of a Court of Law; established, re-established, monumented, re-monumented, recovered, found as expressed below.

NOTE: Not more than 4 corners, all in the same town and range, may be recorded on this certificate.

A. Description of original monument and accessories and/or subsequent restoration:  
March 10, 1831, Robert Clark, Jr., Deputy Surveyor, GLO Notes

- Set Post
- White Oak 13" S87°E 24 links
  - White Oak 16" S64°W 27 links

August 31, 1895, H.M. Caulkin, County Surveyor, page 42  
Found reddish stone with crockery under it and rotten stake under it on westside  
Took up stone and put down 1-1/2" gas pipe 26" long with stone on westside of it.  
October 28, 1994, William G. Tingley, #30401, in Survey #94093  
Found 1-1/2" Gas Pipe

B. Description of corner evidence found and/or method applied in restoring or reestablishing corner:

- Found 1-1/2" gas pipe and crockery 2.5 feet deep
- Found nail Southside Power Pole S80°W 37.13 feet
- Found spike Southeast side 6" poplar N40°E 64.41 feet


C. Description of monument for corner and accessories established to perpetuate locating the position of the corner:

- Set Remonument Corner over gas pipe
- Roosien iron & cap South 6.06 feet
  - Found nail southside power pole S80°W 37.13 feet
  - Found spike Southeast side 6" poplar N40°E 64.41 feet
  - Southeast corner riser box N55°W 28.20 feet

This corner is accepted as a careful and faithful perpetuation of the position of the original corner.

Signed by William G. Tingley Date 12-23, 1996  
Surveyor's Michigan License No. 30104

FORM APPROVED BY MICHIGAN STATE BOARD OF LAND SURVEYORS, JAN. 28, 1871  
REVISED MAY 14, 1975  
REVISED JAN., 1983  
ADAPTED FOR WORD PROCESSING MARCH, 1983

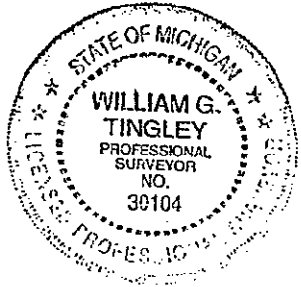

ACCEPTED BY THE MONTCALM COUNTY SURVEY PEER GROUP AS THE OFFICIAL CORNER UNDER MICHIGAN PUBLIC ACT 345 OF 1990 AT A MEETING HELD 12-12-95  
WGT  
William Tingley, PS, Chairman