


SECTION

MONTCALM COUNTY REMONUMENTATION PROGRAM

LAND CORNER RECORDATION CERTIFICATE

Filing Requirement of Act 74, Mich. P.A. 1970

For corners in <u>Montcalm</u> (County)	Located In: <u>Bloomer</u>	Corner Code # <u>I-4, 1/4 Corner</u>
1. Public Land Survey	Sec <u>10 & 11</u> T <u>9</u> N R <u>5</u> W	<u>I-4, 1/4 Corner</u>
	T _____ R _____	_____
	T _____ R _____	_____
	T _____ R _____	_____
2. Property Controlling in Section	S _____ T _____ R _____	_____
	S _____ T _____ R _____	_____
3. Miscellaneous Property in Sec.	S _____ T _____ R _____	_____
	S _____ T _____ R _____	_____
4. Lot No. _____, Recorded Plat _____		
5. Private Claims _____		

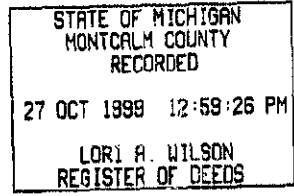

Register of Deeds Stamp & File Number

I, William G. Tingley a field survey on June 18, 1999, do hereby certify that under requirements of P.A. 74, Michigan P.A. of 1970, the corner points mentioned in lines 1 and 2 above were in conformance with regulations and rules therefore as required in the current manual of survey instructions of the United States Department of the Interior, Bureau of Land Management or by a decree of a Court of Law and/or that the corner points mentioned in lines 3, 4 and 5 above were in conformance with the rules of the Michigan Board of Land Surveyors or by a Decree of a Court of Law; established, re-established, monumented, re-monumented, recovered, found as expressed below:

1	A	B	C	D	E	F	G	H	I	J	K	L	M
2	6	5	4	3	2	1							
3													
4	7	8	9	10	11	12							
5													
6	18	17	16	15	14	13							
7													
8	19	20	21	22	23	24							
9													
10	30	29	28	27	26	25							
11													
12	31	32	33	34	35	36							
13													

NOTE: Not more than 2 corners, all in the same town and range, may be recorded on this certificate.

A. Description of original monument and accessories and/or subsequent restoration:

- 1831, Orange Risdon, Deputy Surveyor, GLO Notes
 - Set Quarter Section Post
 - Sugar Tree 14" North 21 links
 - Sugar Tree 8" South 4 links
- 1931, R.D. McNutt, County Surveyor card file
 - Iron - Wood Stake - Glass
 - Concrete fence post South 33 feet
 - Railroad Spike 1963
- 1968, William Downey, RLS, Michigan State Highway Department
 - Set by single proportion 2643.49 feet from either Section Corner. Set 3/4" pipe with broken drain tile 7.52 feet South of South Rail of East-West Railroad Track
 - Railroad Crossbuck N30°W 34.30 feet
 - Railroad Crossbuck S58°E 23.45 feet
 - Maple 24" S30°W 60.96 feet
- Montcalm County Road Commission has same record as 1968
- 1983, George M. Stevenson, Jr. #13600, Surveyor, Liber 555, Page 970
 - Found 3/4" pipe 2644.08 feet North of Southeast Corner of 10 (1/2" pipe) (Continued On Back. . .)

ACCEPTED BY THE MONTCALM COUNTY SURVEY PEER GROUP AS THE OFFICIAL CORNER UNDER MICHIGAN PUBLICACT 345 OF 1990 AT A MEETING HELD 7-28-99


WGT
William Tingley, PS, Chairman

B. Description of corner evidence found and/or method applied in restoring or reestablishing corner:
Found 1/2" Rebar in Mon Box 0.5 feet below surface, next to rebar found a 3/4" Iron Pipe 1.6 feet below surface, near the intersection of Blackmer Rd. and an abandoned Railroad grade.

- Found Nail and Tag#30104 in SE side 34" Maple S35°W 60.35 feet
- Found Nail and Tag#30104 in NE side Power Pole N61°E 104.80 feet
- Found Top Center Underground Telephone Cable Marker N20°W 65.50 feet

C. Description of monument for corner and accessories established to perpetuate locating the position of the corner:

- Set Standard Remonumentation Monument over 3/4" Iron Pipe.
 - Found Nail and Tag#30104 in SE side 34" Maple S35°W 60.35 feet
 - Found Nail and Tag#30104 in NE side Power Pole N61°E 104.80 feet
 - Found Top Center Underground Telephone Cable Marker N20°W 65.50 feet
 - Found Nail and Tag#30104 in SW side 9" Fence Post S38°E 51.15 feet

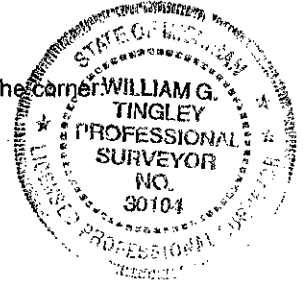

This corner is accepted as a careful and faithful reestablishment of the position of the original corner.

Signed by William G. Tingley Date 7-28, 1999
Surveyor's Michigan License No. 30104



**SURVEY &
REMONUMENTATION**



DEC 1 1990

SECTION

(Continued From Section A. . .)

September 1989, Montcalm County Road Commission

3/4" pipe

30" Maple	S35°W	59.80 feet
Power Pole	N55°E	104.22 feet
Underground telephone marker	N40°W	65.16 feet

1989, W.G. Tingley #30104

Found Monument Box

1990, W.G. Tingley #30104, LCRC, Liber 2, page 329

Found 3/4" Iron Pipe at intersection of Blackmer Road and abandoned railroad grade

30" Maple	S35°W	59.80 feet
Power Pole	N59°E	104.22 feet
Underground Telephone Marker	N40°W	65.16 feet



FD 150 28