

SURVEY & MONUMENTATION

**JAN 17 1998 MONTCALM COUNTY REMONUMENTATION PROGRAM
LAND CORNER RECORDATION CERTIFICATE
COMMISSION Filing Requirement of Act 74, Mich. P.A. 1970**

For corners in Montcalm Located In: Bloomer Township Corner Code # _____
(County)

1. Public Land Survey Sec 1 T 9 N R 5 W K-1, Sec Corner
T _____ R _____
T _____ R _____
T _____ R _____

2. Property Controlling in Section S _____ T _____ R _____
S _____ T _____ R _____

3. Miscellaneous Property in Sec. S _____ T _____ R _____
S _____ T _____ R _____

4. Lot No. _____, Recorded Plat _____

5. Private Claims _____

STATE OF MICHIGAN
MONTCALM COUNTY
RECORDED
20 DEC 95 11:36 A.M.
VIRGINIA L. KNEPPER
REGISTER OF DEEDS
Register of Deeds Stamp & File Number

	A	B	C	D	E	F	G	H	I	J	K	L	M
1													
2	6		5		4		3		2		1		
3													
4	7		8		9		10		11		12		
5													
6	18		17		16		15		14		13		
7													
8	19		20		21		22		23		24		
9													
10	30		29		28		27		26		25		
11													
12	31		32		33		34		35		36		
13													

I, William Tingley a field surveyor on July 7, 1995 do hereby certify that under requirements of P.A. 74, Michigan P.A. of 1970, the corner points mentioned in lines 1 and 2 above were in conformance with regulations and rules therefore as required in the current manual of survey instructions of the United States Department of the Interior, Bureau of Land Management or by a decree of a Court of Law and/or that the corner points mentioned in lines 3, 4 and 5 above were in conformance with the rules of the Michigan Board of Land Surveyors or by a Decree of a Court of Law; established, re-established, monumented, re-monumented, recovered, found as expressed below:

NOTE: Not more than 4 corners, all in the same town and range, may be recorded on this certificate.


- A. Description of original monument and accessories and/or subsequent restoration:
 1831, Orange Risdon, Deputy Surveyor 77.04 chains intersected North boundary 42 links West of post. Set corner to 1 and 2
 Beech 10" S68°N 22 links
 Beech 10" S36°E 55 links
 1891, E.H. Jones, County Surveyor, Liber 2, Page 12, Record of Minutes of Survey
 Northeast Corner of Section 2. This corner is 25 links West of Southeast Corner Section 35, T10N-R5W. New Bearing Trees:
 Pine Stump 24" N71-1/2°W 57 links
 Pine Stump 25" S11-1/2°E 49 links
 R.D. McNutt, County Surveyor, card file records
 Same as above and 1920, replaced stone around
 This Corner is 25 links West of Southeast Corner Section 35, T10N-R5W
 1974, David B. Whittier, LCRC, Liber 1, Page 143
 Found 1/2" Rod in bituminous
 East edge of bituminous - 7.3 feet
 Northeast Corner stone post West Northwest 54.72 feet
 Nail and Flag Southside Telephone Pole East 30.97 feet
 1974, David B. Whittier, #10070, Survey, Liber 483, Page 561
 Same as LCRC Liber 1, Page 143
 1974, Montcalm County Road Commission Records
 Same as Liber 1, page 141, LCRC
 1978, Jerry Jones #19838, Survey, Liber 515, page 999
 Corner not described
 1980, Jerry Jones, Survey Liber 526, Page 254
 Corner not described
 July 1980, R.J. Crater #16924, card file record
 Found as 1974 Whittier
 1985, Jerry Jones, Survey Liber 578 Page 975
 Corner not described
 1986, Jerry Jones, Survey Liber 595, Page 360
 Corner not described

ACCEPTED BY THE MONTCALM COUNTY SURVEY PEER GROUP AS THE OFFICIAL CORNER UNDER MICHIGAN PUBLIC ACT 345 OF 1990 AT A MEETING HELD 12/12/95

WOT
William Tingley, PS, Chairman

Continued on Back

- B. Description of corner evidence found and/or method applied in restoring or reestablishing corner:
 Found Iron and Cap #30104 set previously 25 feet West of Centerline Road and 27.72 feet East of Southwest Corner Section 36, T10N-R5W per GLO Notes
 C. Description of monument for corner and accessories established to perpetuate locating the position of the corner:
 Set Remonumentation Corner over Capped Iron
 Southeast Corner Stone Pillar N50°W 29.50 feet
 Found Nail in 12" Cherry N30°W 37.05 feet
 Found Nail in 12" Poplar S45°W 11.39 feet
 Southwest Corner Section 36, T10N-R5W, East 27.72 feet

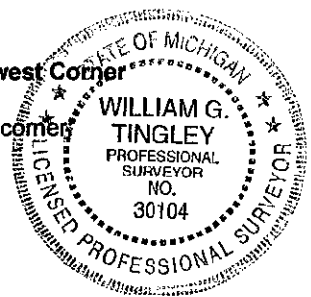

This corner is accepted as a careful and faithful perpetuation of the position of the original corner.
 Signed by William G. Tingley Date 12-12-1995
 Surveyor's Michigan License No. 30104

Continued from Front (K-1, 9-5)

1990, W.G. Tingley #30104, Survey #90341

Set Iron and Cap 25 feet West of Centerline Road

5/8" Rerod East 27.72 feet

Southeast Corner Stone Pillar

Set Nail Eastside 8" Maple

Set Nail Northside 10" Poplar

N50°W

28.90 feet

N40°W

37.06 feet

S45°W

11.57 feet

