


MONTCALM COUNTY REMONUMENTATION PROGRAM

SECTION

LAND CORNER RECORDATION CERTIFICATE

Filing Requirement of Act 74, Mich. P.A. 1970

For corners in Montcalm	Located In:	Corner Code
# _____ (County)	Bloomer Township	
1. Public Land Survey	Sec 1 T 9 N R 5 W	K-2, W 1/4
	T _____ R _____	_____
	T _____ R _____	_____
	T _____ R _____	_____
2. Property Controlling in Section	S _____ T _____ R _____	_____
	S _____ T _____ R _____	_____
3. Miscellaneous Property in Sec.	S _____ T _____ R _____	_____
	S _____ T _____ R _____	_____
4. Lot No. _____, Recorded Plat _____		
5. Private Claims _____		

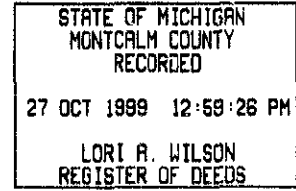

Register of Deeds Stamp & File Number

I, William Tingley a field survey on July 7, 1995, do hereby certify that under requirements of P.A. 74, Michigan P.A. of 1970, the corner points mentioned in lines 1 and 2 above were in conformance with regulations and rules therefore as required in the current manual of survey instructions of the United States Department of the Interior, Bureau of Land Management or by a decree of a Court of Law and/or that the corner points mentioned in lines 3, 4 and 5 above were in conformance with the rules of the Michigan Board of Land Surveyors or by a Decree of a Court of Law; established, re-established, monumented, re-monumented, recovered, found as expressed below:

	A	B	C	D	E	F	G	H	I	J	K	L	M
1													
2	6	5	4	3	2	1							
3													
4	7	8	9	10	11	12							
5													
6	18	17	16	15	14	13							
7													
8	19	20	21	22	23	24							
9													
10	30	29	28	27	26	25							
11													
12	31	32	33	34	35	36							
13													


NOTE: Not more than 2 corners, all in the same town and range, may be recorded on this certificate.

A. Description of original monument and accessories and/or subsequent restoration:

- 1831, Orange Risdon, Deputy Surveyor, GLO Notes
Established 1/4 Section Corner in F. Creek Course Southwest
Beech 24" S20°E 55 links
Elm 9" N20°W 68 links
- 1891, E.H. Jones, County Surveyor,
East 1/4 Post in River - set piece of gaspipe on 1/4 line 50 links West of Corner
Elm 12" N51°W 35 links
- R.D. McNutt, card file record
Same as 1831 and 1891
- 1972 Hunter, Whittier and Associates (William B. Ruddell, # 14769)
Set Pipe
Nail in 7" Maple N45°W 29.38 feet
Nail and Insulator in Northside of 36" Twin Maple S50°W 20.60 feet
Nail in Northside Post West 15.88 feet
- June 1992, W.G. Tingley, #30104, Field Notes #91086
Set Iron and Cap
Set Witness Corner West 33.10 feet
of East 1/4 on East-West 1/4 line
West Edge of Creek East 7.0 feet
Set Nail and Tag on Southside Twin 10" Ash N60°W 47.07 feet
Set Nail and Tag on Eastside Twin 20" Maple N45°W 29.48 feet
Wood Fence Post West 17.00 feet
- April 1994, W.G. Tingley, #30104, Survey #94040
Same Data as 1992

ACCEPTED BY THE MONTCALM COUNTY SURVEY PEER GROUP AS THE OFFICIAL CORNER UNDER MICHIGAN PUBLIC ACT 345 OF 1990 AT A MEETING HELD 7-28-99

WGT
William Tingley, PS, Chairman

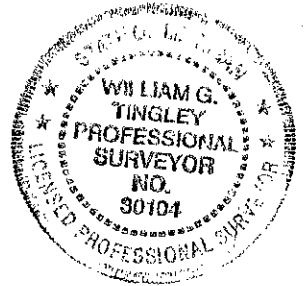

B. Description of corner evidence found and/or method applied in restoring or reestablishing corner:

- Found Cap and Iron #30104
Found wood post West 11.15 feet
Found west bank of creek East 8.65 feet
Found Nail and Tag East Side 24" Maple N38°W 29.45 feet
Found Nail and Tag South Side 22" Twin Ash N60°W 47.09 feet

C. Description of monument for corner and accessories established to perpetuate locating the position of the corner:

- Set Reference Monument over Cap and Iron At Witness Corner of East 1/4 Corner 33.10 feet West on East-West 1/4 line
West Edge of Creek East 8.65 feet
Found Nail and Tag East Side 24" Maple N38°W 29.45 feet
Found Nail and Tag South Side 22" Twin Ash N60°W 47.09 feet
Set Nail and Tag Southwest side 15" Maple N12°W 48.54 feet
Set Nail and Tag Top Center of 4" Wood Post West 11.15 feet

This corner accepted as a careful and faithful reestablishment of the position of the corner as set by the County Surveyor in 1891.

Signed by William Tingley Date 7-28, 1999

Surveyor's Michigan License No. 30104

