

MONTCALM COUNTY REMONUMENTATION PROGRAM
LAND CORNER RECORDATION CERTIFICATE
Filing Requirement of Act 74, Mich. P.A. 1970

JAN 17 1996

COMMISSION

For corners in Montcalm Located In: Bloomer Township Corner Code # _____
(County)

1. Public Land Survey Sec 12 T 9 N R 5 W K-3, Sec. Corner
T _____ R _____
T _____ R _____

2. Property Controlling S _____ T _____ R _____
in Section S _____ T _____ R _____

3. Miscellaneous S _____ T _____ R _____
Property In Sec. S _____ T _____ R _____

4. Lot No. _____, Recorded Plat _____

5. Private Claims _____

STATE OF MICHIGAN
MONTCALM COUNTY
RECORDED
20 DEC 95 11:38 A.M.
VIRGINIA L. KNEPPER
REGISTER OF DEEDS
Register of Deeds Stamp & File Number

I, William Tingley a field survey on July 7, 1995
do hereby certify that under requirements of P.A. 74, Michigan P.A. of 1970, the corner points mentioned in lines 1 and 2 above were in conformance with regulations and rules therefore as required in the current manual of survey instructions of the United States Department of the Interior, Bureau of Land Management or by a decree of a Court of Law and/or that the corner points mentioned in lines 3, 4 and 5 above were in conformance with the rules of the Michigan Board of Land Surveyors or by a Decree of a Court of Law; established, re-established, monumented, re-monumented, recovered, found as expressed below:

	A	B	C	D	E	F	G	H	I	J	K	L	M
1													
2	6	5	4	3	2	1							
3													
4	7	8	9	10	11	12							
5													
6	18	17	16	15	14	13							
7													
8	19	20	21	22	23	24							
9													
10	30	29	28	27	26	25							
11													
12	31	32	33	34	35	36							
13													

NOTE: Not more than 4 corners, all in the same town and range, may be recorded on this certificate.


- A. Description of original monument and accessories and/or subsequent restoration:
- 1831, Orange Risdon, Deputy Surveyor, GLO Notes
Set post corner to Sections 1, 2, 11 and 12
Sugar Tree 24" S45°W 18 links
Ironwood 9" N38°E 15 links
 - 1891, E.H. Jones, Liber 2, Page 12, Record of Minutes of Survey
No corner description
 - 1972, William Ruddell, Survey G-1004, Hunter & Whittier Associates
Found Iron
 - 1988, W.G. Tingley, Field Notes Job 88293
Found 1" Pipe at Fence Corner (Northwest)
Ash 12" S88°W 19.9 feet
Beech 16" S30°W 36.75 feet
Twin Ash 12" N01°E 11.80 feet
 - 1988, Montcalm County Road Commission record
Same as Tingley bearing trees
 - 1989, W.G. Tingley #30104, LCRC, Liber 2, Page 245
Same as 1988
 - 1992 and 1993, W.G. Tingley #30104, Survey
Same as LCRC Liber 2 Page 245
 - 1994, W.G. Tingley #30104, Survey #94049
Found 1-1/2" pipe

ACCEPTED BY THE MONTCALM COUNTY SURVEY PEER GROUP AS THE OFFICIAL CORNER UNDER MICHIGAN PUBLIC ACT 345 OF 1990 AT A MEETING HELD 12-12-95

WGT
William Tingley, PS, Chairman

- B. Description of corner evidence found and/or method applied in restoring or reestablishing corner:
- Found 1-1/2" pipe at fence corner, fence North and West
Ash 12" S88°W 19.9 feet
Beech 16" S30°W 36.75 feet
Twin Ash 12" N01°E 11.80 feet

- C. Description of monument for corner and accessories established to perpetuate locating the position of the corner:
- Set Remonumentation Corner over 1-1/2" pipe.
Ash 12" S88°W 19.9 feet
Beech 16" S30°W 36.75 feet
Twin Ash 12" N01°E 11.80 feet
Corner Fence Post West 0.3 feet

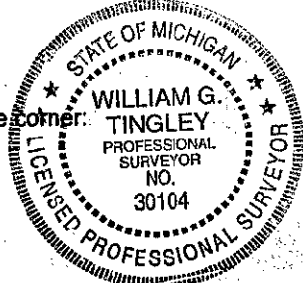

This corner is accepted as the best evidence of the position of the original corner.

Signed by William G. Tingley Date 12-12-1995

Surveyor's Michigan License No. 30104