

SURVEY & REMONUMENTATION

FEB 19 1998

MONTCALM COUNTY REMONUMENTATION PROGRAM

LAND CORNER RECORDATION CERTIFICATE

Filing Requirement of Act 74, Mich. P.A. 1970

SECTION

STATE OF MICHIGAN
MONTCALM COUNTY
RECORDED

26 Dec 1997 3:40:57 PM

LORI A. WILSON
REGISTER OF DEEDS

For corners in <u>Montcalm</u> (County)	Located in: Bloomer Township	Corner Code # L-1, N 1/4
1. Public Land Survey	Sec 1 T 9 N R 5 W	
	T R	
	T R	
	T R	
2. Property Controlling in Section	S T R	
	S T R	
3. Miscellaneous Property in Sec.	S T R	
	S T R	

Register of Deeds Stamp & File Number

4. Lot No. _____, Recorded Plat _____
5. Private Claims _____

I, William Tingley a field survey on September, 1995, do hereby certify that under requirements of P.A. 74, Michigan P.A. of 1970, the corner points mentioned in lines 1 and 2 above were in conformance with regulations and rules therefore as required in the current manual of survey instructions of the United States Department of the Interior, Bureau of Land Management or by a decree of a Court of Law and/or that the corner points mentioned in lines 3, 4 and 5 above were in conformance with the rules of the Michigan Board of Land Surveyors or by a Decree of a Court of Law; established, re-established, monumented, re-monumented, recovered, found as expressed below:

NOTE: Not more than 4 corners, all in the same town and range, may be recorded on this certificate.

A. Description of original monument and accessories and/or subsequent restoration:
GLO not set.

	A	B	C	D	E	F	G	H	I	J	K	L	M
1													
2	6	5	4	3	2	1							
3													
4	7	8	9	10	11	12							
5													
6	18	17	16	15	14	13							
7													
8	19	20	21	22	23	24							
9													
10	30	29	28	27	26	25							
11													
12	31	32	33	34	35	36							
13													

ACCEPTED BY THE MONTCALM COUNTY SURVEY PEER GROUP AS THE OFFICIAL CORNER UNDER MICHIGAN PUBLIC ACT 345 OF 1990 AT A MEETING HELD 5-29-97.

WGT.
William Tingley, PS, Chairman

B. Description of corner evidence found and/or method applied in restoring or reestablishing corner:

Set at mid-point of line between the Northeast corner and the Northwest corner of Section 1.

13.8 feet East of Fence North.

This Corner was set according to BLM instructions

C. Description of monument for corner and accessories established to perpetuate locating the position of the corner:

Set Remonumentation Corner

Set Nail and Tag in 6" Oak N60°E 12.20 feet

Set Nail and Tag in 6" Oak S70°E 2.57 feet

Set Nail and Tag in 8" Oak N65°W 15.44 feet

Remonumentation Corner South 1/4 Corner Section 36-10-5, East 13.83 feet


Fence North East 13.80 feet

This position not established by original government surveyors. This monument is accepted as the best available evidence of the position of the corner.

Signed by William G. Tingley Date 5/28, 1997

Surveyor's Michigan License No. 30104

FORM APPROVED BY MICHIGAN STATE BOARD OF LAND SURVEYORS, JAN. 26, 1971
REVISED MAY 14, 1976
REVISED JAN. 1983
ADAPTED FOR WORD PROCESSING MARCH, 1993

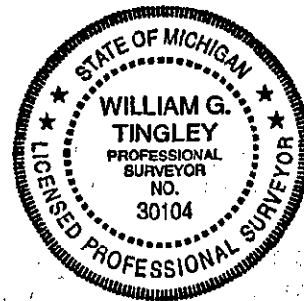

Continued from Front Page (L-1, 9-5)

1986, William Ruddell, Survey Liber 600, Page 664

Same as Liber 2, Page 121

1986, Montcalm County Road Commission

Same as LCRC, Liber 2, Page 121

1986, William Tingley records

Same as LCRC, Liber 2, Page 121

