

SECTION

MONTCALM COUNTY REMONUMENTATION PROGRAM

LAND CORNER RECORDATION CERTIFICATE

Filing Requirement of Act 74, Mich. P.A. 1970

For corners in


Montcalm
(County)

Located In:

Corner Code #

Bloomer Township

1. Public Land Survey	Sec 1	T 9N	R 5W	L-02
		T	R	
		T	R	
		T	R	
2. Property Controlling In Section	S	T	R	
	S	T	R	
3. Miscellaneous Property in Sec.	S	T	R	
	S	T	R	

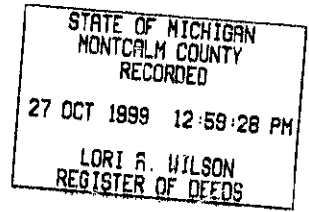

Register of Deeds Stamp & File Number

4. Lot No. _____, Recorded Plat _____
5. Private Claims _____

I, William G. Tingley a field survey on August 14, 1995, do hereby certify that under requirements of P.A. 74, Michigan P.A. of 1970, the corner points mentioned in lines 1 and 2 above were in conformance with regulations and rules therefore as required in the current manual of survey instructions of the United States Department of the Interior, Bureau of Land Management or by a decree of a Court of Law and/or that the corner points mentioned in lines 3, 4 and 5 above were in conformance with the rules of the Michigan Board of Land Surveyors or by a Decree of a Court of Law; established, re-established, monumented, re-monumented, recovered, found as expressed below:

	A	B	C	D	E	F	G	H	I	J	K	L	M
1													
2	6	5	4	3	2	1							
3													
4	7	8	9	10	11	12							
5													
6	18	17	16	15	14	13							
7													
8	19	20	21	22	23	24							
9													
10	30	29	28	27	26	25							
11													
12	31	32	33	34	35	36							
13													

NOTE: Not more than 2 corners, all in the same town and range, may be recorded on this certificate.

A. Description of original monument and accessories and/or subsequent restoration:

1. Not set by GLO

No records were found indicating that the corner was established previously.

B. Description of corner evidence found and/or method applied in restoring or reestablishing corner:

Set Standard Remonumentation pipe in cultivated field at intersection of 1/4 lines.

Nail and Tag in 10" Twin Cherry	S15°E	364.28'
Nail and Tag in 18" Poplar	S25°W	221.16'
Nail and Tag in 18" dead Elm	S32°W	199.32'
Nail and Tag in 16" Cherry	S54°W	279.25'

ACCEPTED BY THE MONTCALM COUNTY SURVEY PEER GROUP AS THE OFFICIAL CORNER UNDER MICHIGAN PUBLIC ACT 345 OF 1990 AT A MEETING HELD 8-18-99

WGT
William Tingley, PS, Chairman

C. Description of monument for corner and accessories established to perpetuate locating the position of the corner:

Set Standard Remonumentation pipe in cultivated field at intersection of 1/4 lines.

Nail and Tag in 10" Twin Cherry	S15°E	364.28'
Nail and Tag in 18" Poplar	S25°W	221.16'
Nail and Tag in 18" dead Elm	S32°W	199.32'
Nail and Tag in 16" Cherry	S54°W	279.25'

Distance from L-01 to L-02 is 2513.29', Distance from L-03 to L-02 is 2641.43', Distance from M-02 to L-02 is 2650.94', Distance from K-02 to L-02 is 2606.59'

The original government surveyors did not establish this corner. This monument is accepted as the best available evidence of the position of the corner.

Bearings given are magnetic. Standard Monumentation consists of a Berntsen stainless steel 30" x 2 3/8" pipe with a brass cap stamped "MONTCALM COUNTY REMONUMENTATION" P.S. 30104

Signed by William G. Tingley
Surveyor's Michigan License No. 30104

Date 8-18, 1999

