

**SURVEY & REMONUMENTATION**

MAY 07 1997

COMMISSION

**GRATIOT COUNTY REMONUMENTATION PROGRAM  
MONTCALM COUNTY REMONUMENTATION PROGRAM  
LAND CORNER RECORDATION CERTIFICATE**  
Filing Requirement of Act 74, Mich. P.A. 1970

STATE OF MICHIGAN  
MONTCALM COUNTY  
RECORDED

11/14/1996 4:03:16 PM

VIRGINIA L. KNEPPER  
REGISTER OF DEEDS

For corners in Montcalm (County) Located in: Crystal Township/Bloomer/ Corner Code #

1. Public Land Survey Sec 36 T 10N R 5W M-13 SE Corner  
 T 9N R 5W M-13 NE Corner  
 T 10N R 4W A-13 SW Corner  
 T 9N R 4W A-1 NW Corner

2. Property Controlling in Section S \_\_\_ T \_\_\_ R \_\_\_  
 S \_\_\_ T \_\_\_ R \_\_\_

3. Miscellaneous Property in Sec. S \_\_\_ T \_\_\_ R \_\_\_  
 S \_\_\_ T \_\_\_ R \_\_\_

4. Lot No. \_\_\_\_\_, Recorded Plat \_\_\_\_\_

5. Private Claims \_\_\_\_\_

GRATIOT

Register of Deeds Stamp & File Number


	A	B	C	D	E	F	G	H	I	J	K	L	M
1													
2	6	5	4	3	2	1							
3													
4	7	8	9	10	11	12							
5													
6	18	17	16	15	14	13							
7													
8	19	20	21	22	23	24							
9													
10	30	29	28	27	26	25							
11													
12	31	32	33	34	35	36							
13													

I, William Tingley a field survey on June 30, 1995, do hereby certify that under requirements of P.A. 74, Michigan P.A. of 1970, the corner points mentioned in lines 1 and 2 above were in conformance with regulations and rules therefore as required in the current manual of survey instructions of the United States Department of the Interior, Bureau of Land Management or by a decree of a Court of Law and/or that the corner points mentioned in lines 3, 4 and 5 above were in conformance with the rules of the Michigan Board of Land Surveyors or by a Decree of a Court of Law; established, re-established, monumented, re-monumented, recovered, found as expressed below:

NOTE: Not more than 4 corners, all in the same town and range, may be recorded on this certificate.

- A. Description of original monument and accessories and/or subsequent restoration:
- 1831, Robert Clark, Jr., Deputy Surveyor, GLO Notes  
 West on South Boundary, Section 31, T10N-R5W  
 75.50 chains - Intersect West boundary of the end of 5 miles 79 chains, 16 links  
 Sugar 16" S42-1/2°E 25 links  
 Sugar 14" N21-1/2°E 21 links  
 North on East Boundary Section 1, T9N-R5W, 79.16 chains - Intersect North Boundary at end of 5 miles 75 chains, 50 links
  - 1869, D.W. Altenburg, Gratiot County Surveyor, Liber B, Page 16, Record of Minutes of Survey  
 Post 3" x 3"  
 Pine Stump 40" N32-1/2°E 50 links  
 Beech 16" S40-1/2°E 61 links
  - 1891, Edward Jones, County Surveyor  
 Pine Stump 42" N25-1/4°E 76 links  
 Pine Stump 42" S66°E 102 links
  - 1935, R.D. McNutt, County Surveyor, Record Cards  
 Found stone  
 Double Wild Cherry Southeast 47.0 feet
  - 1968, Salisbury and Saunders, Surveyors in Consumers Power Company Survey  
 Found stone  
 28" White oak S55°E 28.4 feet  
 Telephone Pole S45°W 40.8 feet  
 Telephone Pole N45°W 90.7 feet
  - 1975, Montcalm County Road Commission

ACCEPTED BY THE MONTCALM COUNTY SURVEY PEER GROUP AS THE OFFICIAL CORNER UNDER MICHIGAN PUBLIC ACT 345 OF 1990 AT A MEETING HELD 11/14/96  
WGT  
 William Tingley, PS, Chairman

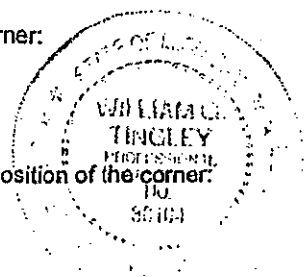

- B. Description of corner evidence found and/or method applied in restoring or reestablishing corner:  
 Found rerod at surface  
 Found 3/4" pipe below rerod  
 Found stone on Eastside of rerod (point end up 0.8' x 0.8' x 1.3')  
 Found crockery around stone
- C. Description of monument for corner and accessories established to perpetuate locating the position of the corner:  
 Set remonumentation corner in place of stone (left stone beside)  
 Found nail in Power Pole S35°W 89.25 feet  
 Found nail in 23" Hickory S30°E 90.37 feet  
 Centerline of 3" Oak N55°E 90.40 feet  
 Top, Center of Cable Riser Box West 24.95 feet

This corner is accepted as a careful and faithful perpetuation of the position of the original corner.

Signed by William Tingley Date 10/8 1996  
 Surveyor's Michigan License No. 30104

FORM APPROVED BY MICHIGAN STATE BOARD OF LAND SURVEYORS, JAN. 28, 1971  
 REVISED MAY 14, 1976  
 REVISED JAN., 1983  
 ADAPTED FOR WORD PROCESSING MARCH, 1993