

DEC 19 2000

MONTCALM COUNTY REMONUMENTATION PROGRAM

SECTION

LAND CORNER RECORDATION CERTIFICATE


Filing Requirement of Act 74, Mich. P.A. 1970

For corners in Montcalm (County)

Located In: Bushnell Township

Corner Code #

- 1. Public Land Survey Sec. 5, 6 T 09 N R 06 W C-02
2. Property Controlling in Section S T R
3. Miscellaneous Property in Sec. S T R
4. Lot No. Recorded Plat
5. Private Claims

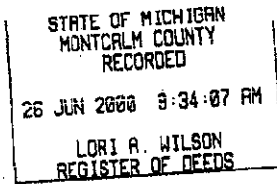

Register of Deeds Stamp & File Number

Grid table with columns A-M and rows 1-13. Cell (2, B) contains a black dot.

I, William G. Tingley, in a field survey on April 19, 2000, do hereby certify that under requirements of P.A. 74, Michigan P.A. of 1970, the corner points mentioned in lines 1 and 2 above were in conformance with regulations and rules therefore as required in the current manual of survey instructions of the United States Department of the Interior, Bureau of Land Management or by a decree of a Court of Law and/or that the corner points mentioned in lines 3, 4 and 5 above were in conformance with the rules of the Michigan Board of Land Surveyors or by a Decree of a Court of Law, established, re-established, monumented, re-monumented, recovered, found as expressed below.

NOTE: Not more than 2 corners, all in the same town and range, may be recorded on this certificate.

A. Description of original monument and accessories and/or subsequent restoration: 1. November 13, 1837, Noah Brookfield, Deputy Surveyor, GLO notes, North between Sections 5 and 6.

- Set quarter post Beech 8" S59°E 6 links (3.96 feet) Beech 10" N45°W 19 links (12.54 feet)

2. No date, George Stevenson corner witness card file, Bushnell Twp # 16 at Tingley and Associates office

- E 1/4 corner Section 6 Tele pole N45°E 42.20 feet Spruce 28" N30°E 86.00 feet Boulder 5' x 3' N85°E 19.00 feet to face

3. August 11, 1976, George M. Stevenson Jr. # 13600, LCRC Liber 001 Page 352

- Found 3/4" iron pipe Tele pole N45°E 42.20 feet Spruce 28" N30°E 86.00 feet Boulder 5' x 3' N85°E 19.00 feet to face


ACCEPTED BY THE MONTCALM COUNTY SURVEY PEER GROUP AS THE OFFICIAL CORNER UNDER MICHIGAN PUBLIC ACT 345 OF 1890 AT A MEETING HELD 6/14/00

Signature of William Tingley, PS, Chairman

B. Description of corner evidence found and/or method applied in restoring or reestablishing corner: Searched in the apparent location of the corner. Excavated 4.00 feet x 5.00 feet x 3.50 feet deep. Found 1/2" x 1.3 foot pipe bent at surface of road. Under pipe was a 1/2" iron pipe that was rotted in pieces that extended to 2.90 feet below the surface of the road. Found no other evidence. Boulder was moved for road construction.

C. Description of monument for corner and accessories established to perpetuate locating the position of the corner: Set remonumentation pipe in place of both pipes.

- Set N/T NW/S Power pole N38°E 60.96 feet Set N/T W/S pine 29" N24°E 86.50 feet Set N/T NE/S twin box elder 15" N38°W 69.41 feet Set N/T S/S quad box elder 22" S89°W 47.82 feet

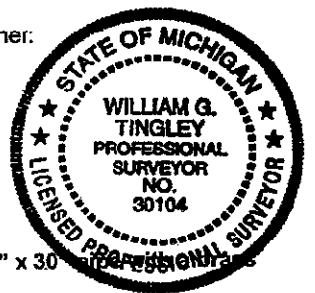

This corner is accepted as the best available evidence of the position of the original corner.

Bearings given are magnetic. Standard remonumentation pipe consists of a Berntsen stainless steel 2 3/8" x 30" cap stamped "MONTCALM COUNTY REMONUMENTATION, P.S. # 30104"

Signed by William Tingley Date June 14, 2000 Surveyor's Michigan License No. 30104

FORM APPROVED BY MICHIGAN STATE BOARD OF LAND SURVEYORS, JAN. 25, 1971 REVISED MAY 14, 1976 REVISED JAN., 1983 ADAPTED FOR WORD PROCESSING MARCH, 1993

