LAND CORNER RECORDATION CERTIFICATE

Filing Requirement of Act 74, Mich. P.A. 1970

For corners in Montcalm (County)

Located In

Corner Code //

1	Public Land Survey		T [illegible]	R [illegible]	[illegible]	E11
			T [illegible]	R [illegible]	[illegible]	E12
			T [illegible]	R [illegible]	[illegible]	E13
			T	R		
2	Property Controlling	S	T	R		
	in Section	S	T	R		
3	Miscellaneous	S	T	R		
	Property in Sec	S	T	R		

Register of Deeds Stamp & File Number

4. Lot No. , Recorded Plat
5. Private Claims

E13 March 05, 1993
E12 February 24, 1993
E11 March 05, 1993

I, Gary C. Below, in a field survey on , 19 , do hereby certify that under requirements of P.A. 74, Michigan P.A. of 1970, the corner points mentioned in lines 1 and 2 above were in conformance with regulations and rules therefore as required in the current manual of survey instructions of the United States Department of the Interior, Bureau of Land Management or by a decree of a Court of Law and/or that the corner points mentioned in lines 3, 4 and 5 above were in conformance with the rules of the Michigan Board of Land Surveyors or by a Decree of a Court of Law, established, re-established, monumented, re-monumented, recovered, found as expressed below

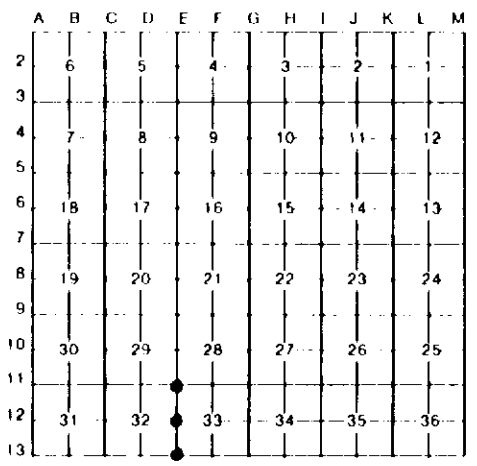

NOTE: Not more than 4 corners, all in the same town and range, may be recorded on this certificate.

A. Description of original monument and accessories and/or subsequent restoration.

E11: Post set by US Deputy Surveyor Noah Brookfield in 1837, accessories a W Oak 30, N45W, 13 and a W Oak 30, S77E, 12. County Surveyor Daoust found evidence of a stake bottom over the remains of a bearing tree which a resident said had marks on the southeast side facing the corner. Daoust set a large stone with crackers and witnessed an Oak 10, S70 3/4W, 141 links.

E12: Pine 10 marked as corner by US Deputy Surveyor Noah Brookfield in 1837. County surveyor Palmer in 1882 notes found stake set in middle of Pine stump which was near to the corner. County surveyor Daoust in 1906 found stone and crackers from BWS stump and witnesses a Pine stump 26 N54W, 2 links and an Oak 4, S55-1/2W, 67 links.

E13: Post set by US Deputy Surveyor Noah Brookfield in 1837, accessories a Pine 10, N12E, 29 and a Pine 30, S34W, 39. County surveyor Daoust set a sleigh shoe with stones around, 60 links east of Ionia s corner in 1906 and witnesses a Poplar 2, S7W, 112 links.

B. Description of corner evidence found and/or method applied in restoring or reestablishing corner:

E11: Found 1-1/4" pipe 15 feet in line with east edge of Crow Road on centerline of Snows Lake Road. Measured 2630.5± to quarter corner west verses 2654.2 Daoust. Distance to section corner southquarter corner not found is about 1.5 feet longer than Daoust. Accepted 1 1/4" pipe as best evidence of original GLO corner location.

E12: No evidence of Daoust set post or accessories was found. Established corner at proportional distances from found section corners north and south and 1/16 corner west. Current measure is within 1 foot of 1906 measure in all directions. Found 1906 1/16 corner south is 1.8 feet west of section line 1.7 feet south of midpoint.

E13: Found iron matching 1906 distances to section corners west and northquarter corners were not found. Iron for Ionia county is 36.22 feet west verses 39.6 calc from GLO and Daoust. Found East 1/16 corner on south line set by Daoust measures 6.1 feet short of 1906 measure. Accepted iron as best evidence of original GLO post location.

C. Description of monument for corner and accessories established to perpetuate locating the position of the corner.

E11: Left 1-1/4" pipe in place 0.4 [illegible] pipe inside 1 1-4" pipe raised to 0.5 below road surface.
N40E, 31.71, spike & tag in 3" W Oak
N43W, 39.95, spike & tag in 20" W Oak
S67W, 65.02, spike & tag in 24" W Oak
N64W, 69.46, spike & tag in 12" Pine

E12: Set 1/2" x 36" rebar encased in a 4 diameter concrete cylinder and capped with a cast aluminum Michigan Department of Natural Resources tablet.
27SE, 36.3±, spike & tag in 13" W Oak
S56W, 24.96, spike & tag in 7" Oak
N57W, 24.84, spike & tag in 8" W Oak
N07W, 35.11, spike & tag in 13" Oak
East, 6, c/l Crow Road(gravel)

E13: Left iron in place 3 feet south of center of Bricker Road and 35 feet east of the center of Crow Road
N19E, 58.29, spike & tag in 11" Oak
N29W, 73.42, spike & tag in 7" Oak
S12W, 35.2, street sign post
N80W, 70.9, NE corner garage

Signed by Gary C. Below

Surveyor's Michigan License No. 26453

Date 5/4/93

STATE OF MICHIGAN GARY C. BELOW PROFESSIONAL SURVEYOR No. LICENSED PROFESSIONAL

FORM APPROVED BY MICHIGAN STATE BOARD OF LAND SURVEYORS JAN. 28, 1971
REVISED MAY 14, 1975
REVISED JAN., 1983

PAGE 35