

LAND CORNER RECORDATION CERTIFICATE
Filing Requirement of Act 74, Mich. P.A. 1970

For corners in
MONTCALM

(County)	Located In:	Corner Code #/1
1. Public Land Survey	T <u>9N</u> R <u>8W</u>	<u>F-13</u>
	T _____ R _____	_____
	T _____ R _____	_____
	T _____ R _____	_____
2. Property Controlling in Section	S <u>33</u> T <u>9N</u> R <u>8W</u>	<u>9</u>
	S _____ T _____ R _____	_____
3. Miscellaneous Property in Sec.	S _____ T _____ R _____	_____
	S _____ T _____ R _____	_____

Register of Deeds Stamp & File Number

4. Lot No. _____, Recorded Plat _____
 5. Private Claims _____

I, GARY C. BILOW, in a field survey on AUGUST 3, 19 90, do hereby certify that under requirements of P.A. 74, Michigan P.A. of 1970, the corner points mentioned in lines 1 and 2 above were in conformance with regulations and rules therefore as required in the current manual of survey instructions of the United States Department of the Interior, Bureau of Land Management or by a decree of a Court of Law and/or that the corner points mentioned in lines 3, 4 and 5 above were in conformance with the rules of the Michigan Board of Land Surveyors or by a Decree of a Court of Law; established, re-established, monumented, re-monumented, recovered, found as expressed below:

NOTE: Not more than 4 corners, all in the same town and range, may be recorded on this certificate.

	A	B	C	D	E	F	G	H	I	J	K	L	M
2	6	5	4	3	2	1							
3													
4	7	8	9	10	11	12							
5													
6	18	17	16	15	14	13							
7													
8	19	20	21	22	23	24							
9													
10	30	29	28	27	26	25							
11													
12	31	32	33	34	35	36							
13													

A. Description of original monument and accessories and/or subsequent restoration:

(F-13) CORNER POST ESTABLISHED BY U.S. GOVERNMENT DEPUTY SURVEYOR NOAH BROOKFIELD, 1837. ACCESSORIES: W. OAK 12 N18E 96; Y. OAK 10 N19W 22. CORNER NOTED IN BOOK NO. 5 OF MICHIGAN STATE HIGHWAY DEPARTMENT PROJECT NO. 59031-R (DATED 1957) AS FOUND 3/4" PIPE WITH ACCESSORIES: N45W 41.64' 27" OAK, S78W 86.24' 26" OAK. DISTANCES ARE ALSO SHOWN TO MONUMENTATION AT E-13 AND G-13. CORNER RECORDED UNDER ACT 74, P.A. 1970 BY RICHARD J. CRATER, LS016924 IN FEB. 1979 AS "FOUND 3/8" ROD; 75' +/- W. OF CENTERLINE STATE HWY M-91, AND 27" (NOW 30") OAK N45W, 41.64". SEE LCRC REC. LIBER 1, PAGE 476.

(9) CORNER NOT SET IN ORIGINAL SURVEY. FOUND NO RECORD OF SUBSEQUENT ESTABLISHMENT.


B. Description of corner evidence found and/or method applied in restoring or reestablishing corner:

(F-13) FOUND NO EVIDENCE OF ORIGINAL CORNER POST OR ACCESSORIES. FOUND AND ACCEPTED "T"-IRON WHICH FITS ABOVE NOTED MEASUREMENT TO 30" OAK TREE (NOW A STUMP) TO THE NORTHWEST. "T"-IRON ALSO FITS WELL WITH MSHD MEASUREMENTS TO E-13 (+0.32') AND G-13 (+0.05').

(9) FOUND NO EVIDENCE OF PRIOR MONUMENTATION. SET 1/2"x3/8" REINFORCING ROD ENCASED IN A 4" DIAMETER CONCRETE CYLINDER CAPPED WITH A CAST ALUMINUM MICHIGAN DEPARTMENT OF NATURAL RESOURCES TABLET AT THE MIDPOINT AND ON LINE BETWEEN F-12 AND G-12 AS DESCRIBED ON LAND CORNER RECORDATION CERTIFICATES ALSO FILED THIS DATE.

C. Description of monument for corner and accessories established to perpetuate locating the position of the corner:

(F-13) FOUND "T"-IRON	(9) SET 4" DIA. CONCRETE MONUMENT AS DESCRIBED ABOVE
S82W 184.86' SET SPIKE AND MDNR TAG IN 30" OAK	S45E 13.99' SET SPIKE AND MDNR TAG IN 12" OAK
S42W 116.5' NW CORNER GARAGE FOUNDATION OF HOUSE NUMBER 8995	S05W 13.06' SET SPIKE AND MDNR TAG IN 12" OAK
EAST 26.68' FOUND "T"-IRON AT N1/4 CORNER OF SECTION 4, T8N-R8W	N14W 12.26' SET SPIKE AND MDNR TAG IN 3" MAPLE
N45W 41.64' 30" OAK STUMP	N65E 15.44' SET SPIKE AND MDNR TAG IN 3" MAPLE

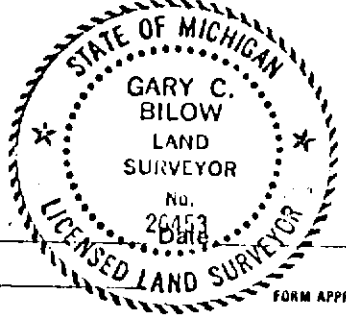

Signed by Gary C. Bilow
 Surveyor's Michigan License No. 26453

2/7/91