

LAND CORNER RECORDATION CERTIFICATE
Filing Requirement of Act 74, Mich. P.A. 1970

For corners in
MONTECALM

(County)	Located In:	Corner Code #
1. Public Land Survey	T 9N R 8W	F-12
	T 9N R 8W	G-12
	T R	
	T R	
2. Property Controlling in Section	S T R	
	S T R	
3. Miscellaneous Property in Sec.	S T R	
	S T R	

Register of Deeds Stamp & File Number

4. Lot No. _____, Recorded Plat _____
 5. Private Claims _____

	A	B	C	D	E	F	G	H	I	J	K	L	M
2	6	5	4	3	2	1							
3													
4	7	8	9	10	11	12							
5													
6	18	17	16	15	14	13							
7													
8	19	20	21	22	23	24							
9													
10	30	29	28	27	26	25							
11													
12	31	32	33	34	35	36							
13													

I, GARY C. BILOW, in a field survey on AUGUST 3, 19 90, do hereby certify that under requirements of P.A. 74, Michigan P.A. of 1970, the corner points mentioned in lines 1 and 2 above were in conformance with regulations and rules therefore as required in the current manual of survey instructions of the United States Department of the Interior, Bureau of Land Management or by a decree of a Court of Law and/or that the corner points mentioned in lines 3, 4 and 5 above were in conformance with the rules of the Michigan Board of Land Surveyors or by a Decree of a Court of Law; established, re-established, monumented, re-monumented, recovered, found as expressed below:

NOTE: Not more than 4 corners, all in the same town and range, may be recorded on this certificate.

A. Description of original monument and accessories and/or subsequent restoration:

(F-12) CORNER NOT MONUMENTED IN ORIGINAL SURVEY. CORNER RECORDED BY RICHARD J. CRATER, RLS #16924, AUGUST 1987 AS "SET NAIL ON CENTERLINE OF HWY. M-91 AT RECORD DISTANCE FROM S1/4 CORNER" (LCRC REC. LIBER 2, PAGE 177). RECORD ACCESSORIES ARE: TEL. POLE, N45W, 47.55'; TEL CABLE BOX, N45E, 68.3'; MEASURED ON SLOPE; NAIL NORTH, 9.89'. FOUND NO OTHER INFORMATION IN THE PUBLIC RECORD CONCERNING THIS CORNER.

(G-12) CORNER POST ESTABLISHED BY U.S. GOVERNMENT DEPUTY SURVEYOR N. BROOKFIELD, 1837. ACCESSORIES: W. OAK 10 S03W 2.07; BURR OAK B N4W 3.20. FOUND NO NOTE OF THIS CORNER IN THE COUNTY SURVEYOR RECORD. CORNER RECORDED UNDER ACT 74, P.A. 1970 JAN. 1981 BY PAUL E. VAN KOOTEN, L.S. #8618 AS SET 3/4" IRON AT EQUAL DISTANCE BETWEEN G-11 AND G-13. SEE LCRC REC. LIBER 1, PAGE 541 FOR RECORD ACCESSORIES.

B. Description of corner evidence found and/or method applied in restoring or reestablishing corner:


(F-12) FOUND AND ACCEPTED PK NAIL IN ASPHALT PAVEMENT. CRATER'S ACCESSORIES CHECK. BASED UPON 1/4 CORNERS ALSO RECORDED THIS DATE, SUBDIVISION OF SECTION 33 REVEALS THIS PK NAIL TO BE 0.05' WEST AND 0.40' SOUTH OF THE INTERSECTION OF STRAIGHT LINES CONNECTING OPPOSITE 1/4 CORNERS.

(G-12) DETERMINED ORIGINAL CORNER TO BE LOST. FOUND 3/4" IRON BY VAN KOOTEN IN ACCORD WITH HIS RECORDED ACCESSORIES BUT 8.59' EAST OF A LINE BETWEEN G-11 AND G-13. DID NOT ACCEPT 3/4" IRON AS FOUND AND MONUMENTED CORNER WITH A 1/2"x36" REBAR ENCASED IN A 4" DIA. CONCRETE CYLINDER AND CAPPED WITH A CAST ALUMINUM MICHIGAN DEPT. OF NATURAL RESOURCES TABLET AT THE MIDPOINT AND ON A STRAIGHT LINE BETWEEN G-11 AND G-13.

C. Description of monument for corner and accessories established to perpetuate locating the position of the corner:

(F-12) FOUND PK NAIL NORTH 9.87' FOUND PK NAIL N14E 46.24' FOUND PK NAIL EAST 50.17' SET 4" DIA. MDNR CONCRETE MONUMENT AT THE INTERSECTION OF E-W 1/4 LINE AND E'LY R/W LINE M-91 EAST 210.00' SET 1/2"x24" REBAR WITH PLASTIC CAP STAMPED "G.C. BILOW L.S. 26453" ON THE E-W 1/4 LINE	(G-12) SET 4" DIA CONCRETE MONUMENT WITH CAST ALUMINUM MDNR TABLET S34E 56.20' SET SPIKE AND MDNR TAG IN POWER POLE N15W 138.17' SET SPIKE AND MDNR TAG IN POWER POLE S21W 126.75' SET SPIKE AND MDNR TAG IN POWER POLE EAST 8.59' FOUND 3/4" IRON WITH CAP #8618 PREVIOUSLY RECORDED AS G-12 4' CENTERLINE OF E-W MOTORBIKE TRAIL
---	---

Signed by Gary C. Bilow
 Surveyor's Michigan License No. 26453

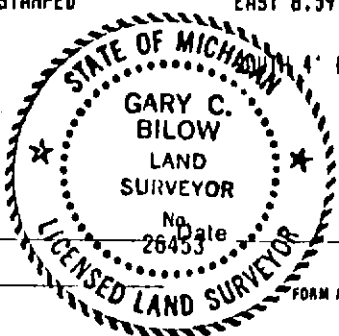

FORM APPROVED BY MICHIGAN STATE BOARD OF LAND SURVEYORS, JAN. 28, 1971
 REVISED MAY 14, 1978
 REVISED JAN., 1983