

SURVEY & REMONUMENTATION

MAR 11 1998

MONTCALM COUNTY REMONUMENTATION PROGRAM

LAND CORNER RECORDATION CERTIFICATE

Filing Requirement of Act 74, Mich. P.A. 1970

For corners in **SECTION**
Montcalm
 (County)

Located In: Eureka Township Corner Code #

- 1. Public Land Survey Sec 8 T 9N R 8W C-5, SW Corner
- 2. Property Controlling in Section S T R
- 3. Miscellaneous Property in Sec. S T R
- 4. Lot No. , Recorded Plat
- 5. Private Claims

STATE OF MICHIGAN
 MONTCALM COUNTY
 RECORDED
 26 Dec 1997 3:37:19 PM
 LORI A. WILSON
 REGISTER OF DEEDS
 Register of Deeds Stamp & File Number

1	A	B	C	D	E	F	G	H	I	J	K	L	M
2	6	5	4	3	2								
3													
4	7	8	9	10	11	12							
5													
6	18	17	16	15	14	13							
7													
8	19	20	21	22	23	24							
9													
10	30	29	28	27	26	25							
11													
12	31	32	33	34	35	36							
13													

I, William Tingley a field survey on July 22nd, 1996, do hereby certify that under requirements of P.A. 74, Michigan P.A. of 1970, the corner points mentioned in lines 1 and 2 above were in conformance with regulations and rules therefore as required in the current manual of survey instructions of the United States Department of the Interior, Bureau of Land Management or by a decree of a Court of Law and/or that the corner points mentioned in lines 3, 4 and 5 above were in conformance with the rules of the Michigan Board of Land Surveyors or by a Decree of a Court of Law; established, re-established, monumented, re-monumented, recovered, found as expressed below:

NOTE: Not more than 4 corners, all in the same town and range, may be recorded on this certificate.

A. Description of original monument and accessories and/or subsequent restoration: December 9, 1837, Noah Brookfield, Deputy Surveyor, GLO Notes

- Set Post
- White Oak 12" N19°W 69 links
- Black Oak 18" S64°E 54 links
- 1878, H.M. Caulkins from R.D. McNutt's index cards #37, 9-8
- White Oak 20" (N.M.) N22-1/2°W 74 links (48.8 feet)
- January 1930, R.D. McNutt, Field Book, Page 74, Consumer Power Survey
- From Oak N22-1/2°W 74 links
- New Bearing Tree: Maple 12" Southeast 53 feet
- Maple 10" Southwest 40 feet

ACCEPTED BY THE MONTCALM COUNTY SURVEY PEER GROUP AS THE OFFICIAL CORNER UNDER MICHIGAN PUBLIC ACT 345 OF 1990 AT A MEETING HELD 3-29-97

WGT
 William Tingley, PS, Chairman

Record of Montcalm County Road Commission

- Found Stone, placed iron pipe
- 20" Oak Northwest 48.8 feet
- 10" Maple Southwest 40.00 feet
- 28" Maple Southwest 86.06 feet
- 23" Oak Northeast 133.59 feet
- 14" Ash Northwest 114.64 feet

May 1963, Michigan State Highway Department

- Found 1-1/4" Pipe in Mon Box
- Ash 14" N17°W 114.64 feet
- Oak 23" N25°E 133.59 feet
- Maple 28" S14°W 86.06 feet

1972, R. J. Crater, #16924

Found Corner, bearings trees of Michigan State Highway Department

Continued on back


B. Description of corner evidence found and/or method applied in restoring or reestablishing corner:

- Found Re-rod in Monument Box, witnesses as Liber 3, page 38 above.
- Also face of curb N35°W 41.00 feet
- Also face of curb N40°E 53.65 feet

C. Description of monument for corner and accessories established to perpetuate locating the position of the corner:

Set Remonumentation Corner in Monument Box over Iron

- P.K. Nail in Northeast side Power Pole N50°W 135.90 feet
- P.K. Nail in East side Guy Pole S45°W 77.66 feet
- P.K. Nail in Northeast side Telephone Pole S45°E 84.85 feet
- P.K. Nail in Southeast side Power Pole (3-1/2 feet above ground) N40°E 82.34 feet
- Face of curb at 4th joint from end N35°W 41.00 feet
- Face of curb, 3rd joint from end N40°E 53.65 feet

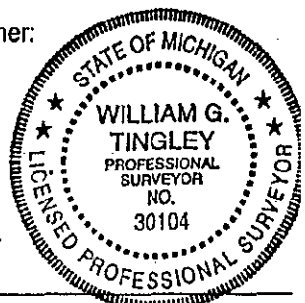

Signed by William G. Tingley

Date 5/27 1997

Surveyor's Michigan License No. 30104

FORM APPROVED BY MICHIGAN STATE BOARD OF LAND SURVEYORS, JAN. 28, 1971
 REVISED MAY 14, 1978
 REVISED JAN., 1993
 ADAPTED FOR WORD PROCESSING MARCH, 1992

