

SURVEY & REMONUMENTATION

FEB 19 1998

MONTCALM COUNTY REMONUMENTATION PROGRAM

SECTION

LAND CORNER RECORDATION CERTIFICATE

Filing Requirement of Act 74, Mich. P.A. 1970

**STATE OF MICHIGAN
MONTCALM COUNTY
RECORDED**

For corners in

Montcalm
(County)

Located In: _____ Corner Code # _____

Eureka Township

26 Dec 1997 3:38:07 PM

**LORI A. WILSON
REGISTER OF DEEDS**

- 1. Public Land Survey Sec 8 T 9N R 8W D-5, S-1/4"
- 2. Property Controlling in Section S T R
- 3. Miscellaneous Property in Sec. S T R

Register of Deeds Stamp & File Number

- 4. Lot No. _____ Recorded Plat _____
- 5. Private Claims _____

	A	B	C	D	E	F	G	H	I	J	K	L	M
12	6	5	4	3	2	1							
3													
4	7	8	9	10	11	12							
5													
6	18	17	16	15	14	13							
7													
8	19	20	21	22	23	24							
9													
10	30	29	28	27	26	25							
11													
12	31	32	33	34	35	36							
13													

I, William Tingley a field surveyor on 1996 do hereby certify that under requirements of P.A. 74, Michigan P.A. of 1970, the corner points mentioned in lines 1 and 2 above were in conformance with regulations and rules therefore as required in the current manual of survey instructions of the United States Department of the Interior, Bureau of Land Management or by a decree of a Court of Law and/or that the corner points mentioned in lines 3, 4 and 5 above were in conformance with the rules of the Michigan Board of Land Surveyors or by a Decree of a Court of Law; established, re-established, monumented, re-monumented, recovered, found as expressed below.

NOTE: Not more than 4 corners, all in the same town and range, may be recorded on this certificate.

A. Description of original monument and accessories and/or subsequent restoration:
December 9, 1837, Noah Brookfield, Deputy Surveyor, GLO Notes

Set Post in Tree Line

- White Oak 8" N67°W 15 links
- White Oak 12" N12°E 17 links

1878 H.M. Caulkins from R.D. McNutt's Index Cards, #61, 9-8

Stone, Red spots

- Fence post N47-1/2°W 71-1/2 links

1909, H.M. Caulkins from R.D. McNutt's Index Cards #39, 9-8

Fence post Southwest Corner is 50 links South of Section line and 50 links West of 1/4 line

January 1930, R.D. McNutt, Field Book, Page 74

Iron Crockery

- Maple Southwest 37.7 feet
- Maple 10" Northwest 56.0 feet
- Apple 8" Southeast 59.5 feet

May 1963, Michigan State Highway Department

Found 1-1/4" Pipe in Mon Box

- Southeast Corner 2-story frame house N52°W 123.40 feet
- Power Pole N8°E 95.02 feet
- Power Pole S19°W 49.62 feet

October 1972, R.J. Crater #16924, Liber 467, Page 764, Recorded LCRC

Found Iron in Mon Box

Same witnesses as Michigan State Highway Department

Continued on Back

B. Description of corner evidence found and/or method applied in restoring or reestablishing corner:

Found Boat Spike in Monument Box

Also Bonneman's bearing objects LCRC Liber 3, Page 38 and 1985 witness to house N52°W, 123.40 feet which is OBT Michigan State, 1963.

C. Description of monument for corner and accessories established to perpetuate locating the position of the corner:

Set Remonumentation Corner over Boat Spike

- P.K. in Power Pole S45°E 52.03 feet
- P.K. in East side Power Pole S45°W 67.56 feet
- P.K. in East side Power Pole N45°E 62.59 feet
- P.K. in Top of "Head" of Curb N40°W 47.19 feet

This corner is accepted as the best available evidence of the position of the original corner.

Signed by William G. Tingley Date 5/28, 1997

Surveyor's Michigan License No. 30104

FORM APPROVED BY MICHIGAN STATE BOARD OF LAND SURVEYORS, JAN. 28, 1971
REVISED MAY 14, 1976
REVISED JAN., 1983
ADAPTED FOR WORD PROCESSING MARCH, 1983

Continued from Front (D-5, 9-8)

February 1974, R.J. Crater #16924, Liber 1, Page 273, Recorded LCRC

Found 1-1/4" Pipe in Mon. Box

Same witnesses as Michigan State Highway Department

May 1985, Douglas W. Bonnema, #12579, Liber 557, page 603, Recorded Survey

Found Nail in Center of Mon Box

Power Pole	S19°W	49.62 feet
Southeast Corner frame house	N52°W	123.40 feet
Power Pole	N08°E	95.02 feet

On Centerline of new pavement

April 1989, D.L. Herrema, #24597, Liber 637, Page 308, Recorded Survey

Herrema incorrectly shows witnesses on survey showing the South 1/4 witnessed for the Southeast

Corner. Following are the corrections.

August 1989, D.L. Herrema, #24597, Liber 637, Page 309


Boat Spike in Monument Box

P.K. East side Power Pole	Southeast	51.91 feet
P.K. East side Power Pole	Southwest	67.51 feet
P.K. West side Power Pole	Northeast	62.56 feet

January 1993, D.W. Bonnema, #12579, Liber 3, Page 38, Recorded LCRC

Found Boat Spike in Mon Box and Centerline M-57 and on Centerline Youngman Road

Set P.K. Nail in Top of Head of Curb	Northwest	47.19 feet
Found P.K. in East side Power Pole	Southeast	52.03 feet
Found P.K. in East side Power Pole	Southwest	67.56 feet
Found P.K. in West side Power Pole	Northeast	62.59 feet

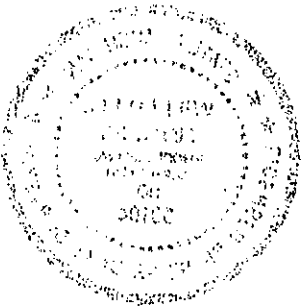

