

SURVEY & REMONUMENTATION

FEB 19 1998

SECTION

MONTCALM COUNTY REMONUMENTATION PROGRAM

LAND CORNER RECORDATION CERTIFICATE

Filing Requirement of Act 74, Mich. P.A. 1970

For corners in Montcalm (County) Located in: Eureka Township Corner Code # _____

1. Public Land Survey	Sec 10	T 9N	R 8W	I-3, NE Corner
		T _____	R _____	_____
		T _____	R _____	_____
		T _____	R _____	_____
2. Property Controlling in Section	S _____	T _____	R _____	_____
	S _____	T _____	R _____	_____
3. Miscellaneous Property in Sec.	S _____	T _____	R _____	_____
	S _____	T _____	R _____	_____

4. Lot No. _____, Recorded Plat _____

5. Private Claims _____

STATE OF MICHIGAN
MONTCALM COUNTY
RECORDED
26 Dec 1997 3:37:45 PM
LORI A. WILSON
REGISTER OF DEEDS
Register of Deeds Stamp & File Number

I, William Tingley a field surveyor on , 1996 do hereby certify that under requirements of P.A. 74, Michigan P.A. of 1970, the corner points mentioned in lines 1 and 2 above were in conformance with regulations and rules therefore as required in the current manual of survey instructions of the United States Department of the Interior, Bureau of Land Management or by a decree of a Court of Law and/or that the corner points mentioned in lines 3, 4 and 5 above were in conformance with the rules of the Michigan Board of Land Surveyors or by a Decree of a Court of Law; established, re-established, monumented, re-monumented, recovered, found as expressed below:

NOTE: Not more than 4 corners, all in the same town and range, may be recorded on this certificate.

A. Description of original monument and accessories and/or subsequent restoration:
November 30, 1837, Noah Brookfield, Deputy Surveyor, GLO Notes

- Set Post
 - White Oak 18" S16°W 32 links
 - White Oak 20" S74°E 22 links
- County Records Field Book, Page 8
- 1857, Set Red Cedar Post
- 1867, Stone 13 x 7 x 6 Glass, Round Stone 10" diameter under it (HMC)
- R.D. McNutt's Index Cards, 9-8, #20
- 1937, Stone
 - Butternut 30" S42-1/2°W 50.6 feet
 - Walnut 8" S51°E 59.0 feet

April 1973, F.E. Spicer, #7877, Liber 472, Page 145, Recorded Survey

- Set Railroad Spike
 - Northeast corner garage S10°W 107.75 feet
 - 32" Walnut S60°E 86.08 feet
 - Power Pole N65°E 88.83 feet
 - Telephone Pole N10°W 63.69 feet
- In Centerline East & West road and road North

Continued on back.....

B. Description of corner evidence found and/or method applied in restoring or reestablishing corner:

- Found P.K. Nail in pavement on Centerline of Gravel Road North
- Nail in Root of 32" Walnut S60°E 86.45 feet
- Found spike in East side 48" Walnut S50°W 50.35 feet (Butternut?)
- Found spike in 18" Walnut S50°E 60.65 feet

C. Description of monument for corner and accessories established to perpetuate locating the position of the corner:


- Set Remonumentation in Monument Box in place of P.K. Nail
- Center top of Hydrant S50°E 51.85 feet
- Nail and Tag in Light Pole S60°E 30.00 feet
- Nail in Root of 32" Walnut S60°E 86.45 feet
- Found spike in East side 48" Walnut S45°W 50.35 feet
- Found spike in West 18" Walnut S50°E 60.65 feet

This corner is accepted as a careful and faithful perpetuation of the position of the original corner.

Signed by William Tingley Date 5/28, 1997

Surveyor's Michigan License No. 30104

FORM APPROVED BY MICHIGAN STATE BOARD OF LAND SURVEYORS, JAN. 28, 1971

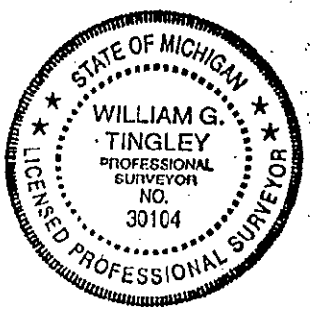

WGT
William Tingley, PS, Chairman

1	A	B	C	D	E	F	G	H	I	J	K	L	M
2	6	5	4	3	2								
3													
4	7	8	9	10	11	12							
5													
6	18	17	16	15	14	13							
7													
8	19	20	21	22	23	24							
9													
10	30	29	28	27	26	25							
11													
12	31	32	33	34	35	36							
13													

ACCEPTED BY THE MONTCALM COUNTY SURVEY PEER GROUP AS THE OFFICIAL CORNER UNDER MICHIGAN PUBLIC ACT 345 OF 1990 AT A MEETING HELD 5-28-27.

