

MAY 07 1997

COMMISSION

MONTCALM COUNTY REMONUMENTATION
LAND CORNER RECORDATION CERTIFICATE
Filing Requirement of Act 74, Mich. P.A. 1970

For corners in Montcalm Located in: Crystal Township Corner Code # _____
(County)

1. Public Land Survey Sec. 5 T 10 N R 5 W D-1, N 1/4
T _____ R _____
T _____ R _____
T _____ R _____

2. Property Controlling S _____ T _____ R _____
in Section S _____ T _____ R _____

3. Miscellaneous S _____ T _____ R _____
Property in Sec. S _____ T _____ R _____

4. Lot No. _____, Recorded Plat _____

5. Private Claims _____

STATE OF MICHIGAN
MONTCALM COUNTY
RECORDED

11/14/1996 4:02:01 PM

VIRGINIA L. KNEPPER
REGISTER OF DEEDS

Register of Deeds Stamp & File Number

I, William Tingley a field survey on March 18, 1995, do hereby certify that under requirements of P.A. 74, Michigan P.A. of 1970, the corner points mentioned in lines 1 and 2 above were in conformance with regulations and rules therefore as required in the current manual of survey instructions of the United States Department of the Interior, Bureau of Land Management or by a decree of a Court of Law and/or that the corner points mentioned in lines 3, 4 and 5 above were in conformance with the rules of the Michigan Board of Land Surveyors or by a Decree of a Court of Law; established, re-established, monumented, re-monumented, recovered, found as expressed below:

NOTE: Not more than 4 corners, all in the same town and range, may be recorded on this certificate.

A. Description of original monument and accessories and/or subsequent restoration:

September 12-13, 1912, E.Duff Youdan, Field Book 11-5, Page 49 and 50

Found Light Railroad Rail and Stake S88-3/4°E 125 feet from 32 and 33 South Boundary T11N R5W

Took New Bearing Trees: Pine 12" N57-1/2°W 73-1/2 feet

Elm 6" N78°E 117 feet

July 1, 1925, Michigan State Highway Dept, M-43, Project 11

Station 405 and 72.0 "T" Rail 1.8 feet North of Centerline 125.05 East of 32-33 Ferris Township

May 13, 1987, August 4, 1987, Thomas Mueller #25861, recorded Liber 612, Page 341 and Liber 2, Page 180

Found Monument Box at Road Intersection and 125 feet East of Monument Box T11N R5W

Power Pole Northeast 92.81 feet

Power Pole East Southeast 89.54 feet

Poplar 18" Southwest 72.11 feet

Power Pole Northwest 156.06 feet


B. Description of corner evidence found and/or method applied in restoring or reestablishing corner:

Found 1" Iron in Monument Box 125.1 feet East of Section Corner 32 and 33 T11N-R5W agreeing with 1987 bearing trees above Centerline gravel road South.

C. Description of monument for corner and accessories established to perpetuate locating the position of the corner:

Set Remonumentation Corner in Monument Box.

Nail in Power Pole	N45°E	92.81 feet
Nail in Power Pole	S60°E	89.54 feet
Nail in 18" Poplar	S40°W	72.11 feet
Nail in Power Pole	N70°W	156.06 feet

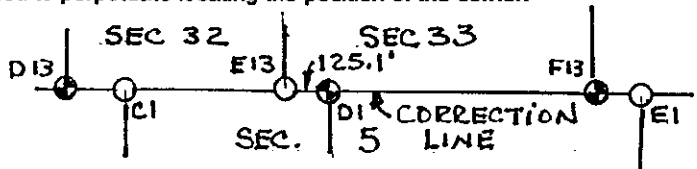

This position not established by original government surveyors. This monument is accepted as the best available evidence of the position of the corner.

Signed by William Tingley Date 10/8/96, 1996

Surveyor's Michigan License No. 30104

FORM APPROVED BY MICHIGAN STATE BOARD OF LAND SURVEYORS, JAN. 28, 1971
REVISED MAY 14, 1975
REVISED JAN., 1993
ADAPTED FOR WORD PROCESSING MARCH, 1993



ACCEPTED BY THE MONTCALM COUNTY SURVEY PEER GROUP AS THE OFFICIAL CORNER UNDER MICHIGAN PUBLIC ACT 345 OF 1990 AT A MEETING HELD 10/8/96

William Tingley
William Tingley, PS, Chairman