

MAY 07 1997

COMMISSION

**MONTCALM COUNTY REMONUMENTATION  
LAND CORNER RECORDATION CERTIFICATE**  
Filing Requirement of Act 74, Mich. P.A. 1970

For corners in Montcalm Located In: Crystal Township Corner Code # \_\_\_\_\_  
(County)

1. Public Land Survey Sec. 5& T 10 NR 5W E-1  
4 T \_\_\_\_\_ R \_\_\_\_\_  
T \_\_\_\_\_ R \_\_\_\_\_  
T \_\_\_\_\_ R \_\_\_\_\_

2. Property Controlling S \_\_\_\_\_ T \_\_\_\_\_ R \_\_\_\_\_  
in Section S \_\_\_\_\_ T \_\_\_\_\_ R \_\_\_\_\_

3. Miscellaneous S \_\_\_\_\_ T \_\_\_\_\_ R \_\_\_\_\_  
Property in Sec. S \_\_\_\_\_ T \_\_\_\_\_ R \_\_\_\_\_

4. Lot No. \_\_\_\_\_, Recorded Plat \_\_\_\_\_

5. Private Claims \_\_\_\_\_

STATE OF MICHIGAN  
MONTCALM COUNTY  
RECORDED

11/14/1996 4:02:19 PM

VIRGINIA L. KNEPPER  
REGISTER OF DEEDS

Register of Deeds Stamp & File Number


	A	B	C	D	E	F	G	H	I	J	K	L	M
1													
2	6			5		4		3		2		1	
3													
4	7			8		9		10		11		12	
5													
6	18			17		16		15		14		13	
7													
8	19			20		21		22		23		24	
9													
10	30			29		28		27		26		25	
11													
12	31			32		33		34		35		36	
13													

I, William Tingley a field survey on October 31, 1995, do hereby certify that under requirements of P.A. 74, Michigan P.A. of 1970, the corner points mentioned in lines 1 and 2 above were in conformance with regulations and rules therefore as required in the current manual of survey instructions of the United States Department of the Interior, Bureau of Land Management or by a decree of a Court of Law and/or that the corner points mentioned in lines 3, 4 and 5 above were in conformance with the rules of the Michigan Board of Land Surveyors or by a Decree of a Court of Law; established, re-established, monumented, re-monumented, recovered, found as expressed below:

NOTE: Not more than 4 corners, all in the same town and range, may be recorded on this certificate.

A. Description of original monument and accessories and/or subsequent restoration:  
October 4, 1831, Orange Risdon, Deputy Surveyor, GLO Notes  
Intersected North Boundary 1 chain 90 links East of 1/4 Section Post (T11N R5W)  
Set Post  
Beech 18" S63°E 35 links  
White Ash 24" S52°W 50 links  
1883, F.A. Palmer, County Surveyor, Surveyor Notes  
Established Quarter Post Northside 3 and made New Bearing Tree: Black Ash S19°E 53 feet  
September 12-13, 1912, E. Duff Youdan, County Surveyor, Field Book 10-5, Page 49 and 50  
Reestablished 126-2/3 feet East of Quarter Post  
Southside 33 T11N R5W  
Drove Gaspipe 1" x 3' long  
July 1, 1925, Michigan Highway Dept., M-43, Project 11  
Railroad spike?

B. Description of corner evidence found and/or method applied in restoring or reestablishing corner:  
Found 1/2" Rerod at surface. At 1.1 feet below surface found 1" x 3 feet gas pipe. Removed bent rerod, Left gas pipe.

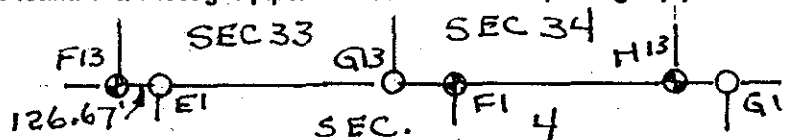

C. Description of monument for corner and accessories established to perpetuate locating the position of the corner:  
Set Remonumentation Monument over gas pipe with Monument Box

Centerline Stanton Road	South	7.8 feet
Centerline Field Drive to North	West	13.0 feet
Set Nail & Tag in Northwest side 8" Elm	S20°W	34.96 feet
Locate on Centerline tree row South		
North 1/4 Corner Section 5	West	2644.46 feet
North 1/4 Corner Section 4	East	2631.18 feet


ACCEPTED BY THE MONTCALM COUNTY SURVEY PEER GROUP AS THE OFFICIAL CORNER UNDER MICHIGAN PUBLIC ACT 345 OF 1990 AT A MEETING HELD 10/18/96

*William Tingley*  
William Tingley, PS, Chairman

This corner is accepted as a careful and faithful perpetuation of the position of the original corner.

Signed by William Tingley Date 10/18/96

Surveyor's Michigan License No. 30104

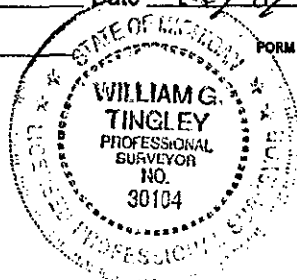

FORM APPROVED BY MICHIGAN STATE BOARD OF LAND SURVEYORS, JAN. 26, 1971  
REVISED MAY 14, 1971  
REVISED JAN. 1981  
ADAPTED FOR WORD PROCESSING MARCH, 1981