

MONTCALM COUNTY REMONUMENTATION PROGRAM
LAND CORNER RECORDATION CERTIFICATE
 Filing Requirement of Act 74, Mich. P.A. 1970

DEC 19 2000

SECTION

For corners in Montcalm Located In: Crystal Township Corner Code # _____
 (County)


1. Public Land Survey Sec. 32,33 T 10 N R 05 W E-12
 T _____ R _____
 T _____ R _____
 T _____ R _____

2. Property Controlling S _____ T _____ R _____
 in Section S _____ T _____ R _____

3. Miscellaneous S _____ T _____ R _____
 Property in Sec. S _____ T _____ R _____

4. Lot No. _____, Recorded Plat _____

5. Private Claims _____

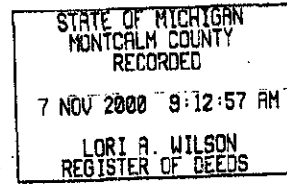

Register of Deeds Stamp & File Number

1	A	B	C	D	E	F	G	H	I	J	K	L	M
2	6	5	4	3	2	1							
3													
4	7	8	9	10	11	12							
5													
6	18	17	16	15	14	13							
7													
8	19	20	21	22	23	24							
9													
10	30	29	28	27	26	25							
11													
12	31	32	33	34	35	36							
13													

I, William G. Tingley, in a field survey on June 7, 2000, do hereby certify that under requirements of P.A. 74, Michigan P.A. of 1970, the corner points mentioned in lines 1 and 2 above were in conformance with regulations and rules therefore as required in the current manual of survey instructions of the United States Department of the Interior, Bureau of Land Management or by a decree of a Court of Law and/or that the corner points mentioned in lines 3, 4 and 5 above were in conformance with the rules of the Michigan Board of Land Surveyors or by a Decree of a Court of Law; established, re-established, monumented, re-monumented, recovered, found as expressed below:

NOTE: Not more than 2 corners, all in the same town and range, may be recorded on this certificate.

A. Description of original monument and accessories and/or subsequent restoration:


- May 17, 1832, Orange Risdon, Deputy Surveyor, GLO notes, North between Sections 32 and 33**
 40.00 chains Set 1/4 section post
 Beech 9" N59°E 33 links (21.78 feet)
 Beech 16" S48°W 21 links (13.86 feet)
- April 13, 1908, John F. Daoust, County Surveyor, Book 003 Page 316**
 Found stone and gas pipe agreeing with improvements
 Fence post S87°W 38 links (25.08 feet)
- May 12, 1909, John F. Daoust, County Surveyor, Book 003 Page 368**
 Found corner as described on Page 316
 No witnesses given

ACCEPTED BY THE MONTCALM COUNTY SURVEY PEER GROUP AS THE OFFICIAL CORNER UNDER MICHIGAN PUBLIC ACT 345 OF 1990 AT A MEETING HELD 10/11/00

WGT
 William Tingley, PS, Chairman

B. Description of corner evidence found and/or method applied in restoring or reestablishing corner:

Searched apparent location of the corner. Excavated 3.00 feet x 8.00 feet x 6.00 feet deep in the Centerline of both roads and found no evidence of the original corner. Prorated the location between E-11 and E-13 and set corner.

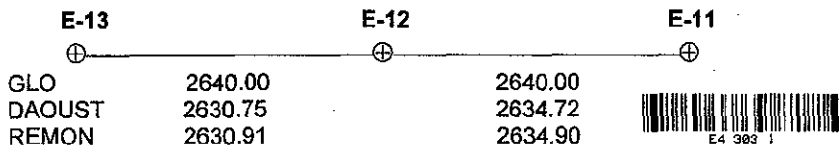

LIBER 4 PAGE 303

C. Description of monument for corner and accessories established to perpetuate locating the position of the corner:

- Set remonumentation pipe in a monument box prorated between E-11 and E-13**
- Set N/T SE/S power pole N52°E 66.45 feet
 - Set N/T W/S power pole S05°W 319.08 feet
 - SE/S 8" guy pole for grain leg S41°W 215.19 feet
 - T/C # 6400 phone riser N70°W 27.30 feet
 - Distance to E-11 North 2634.90 feet
 - Distance to E-13 South 2630.91 feet



This corner is accepted as the careful and faithful reestablishment of the position of the original corner.

Bearings given are magnetic. Standard remonumentation pipe consists of a Berntsen stainless steel 2 3/8" pipe with a brass cap stamped "MONTCALM COUNTY REMONUMENTATION, P.S. # 30104"

Signed by William Tingley Date 10/11/00

Surveyor's Michigan License No. 30104