

**SURVEY & REMONUMENTATION**

MAY 07 1997

COMMISSION

**MONTCALM COUNTY REMONUMENTATION  
LAND CORNER RECORDATION CERTIFICATE  
Filing Requirement of Act 74, Mich. P.A. 1970**

STATE OF MICHIGAN  
MONTCALM COUNTY  
RECORDED

11/14/1996 4:02:32 PM

VIRGINIA L. KNEPPER  
REGISTER OF DEEDS

Register of Deeds Stamp & File Number

For corners in Montcalm (County) Located in: Crystal Township Corner Code # \_\_\_\_\_

1. Public Land Survey Sec. 4 T 10 N R 5 W F-1, N 1/4  
 T \_\_\_\_\_ R \_\_\_\_\_  
 T \_\_\_\_\_ R \_\_\_\_\_  
 T \_\_\_\_\_ R \_\_\_\_\_

2. Property Controlling in Section S \_\_\_\_\_ T \_\_\_\_\_ R \_\_\_\_\_  
 S \_\_\_\_\_ T \_\_\_\_\_ R \_\_\_\_\_

3. Miscellaneous Property in Sec. S \_\_\_\_\_ T \_\_\_\_\_ R \_\_\_\_\_  
 S \_\_\_\_\_ T \_\_\_\_\_ R \_\_\_\_\_

4. Lot No. \_\_\_\_\_, Recorded Plat \_\_\_\_\_


5. Private Claims \_\_\_\_\_

I, William Tingley a field survey on March 22, 1995, do hereby certify that under requirements of P.A. 74, Michigan P.A. of 1970, the corner points mentioned in lines 1 and 2 above were in conformance with regulations and rules therefore as required in the current manual of survey instructions of the United States Department of the Interior, Bureau of Land Management or by a decree of a Court of Law and/or that the corner points mentioned in lines 3, 4 and 5 above were in conformance with the rules of the Michigan Board of Land Surveyors or by a Decree of a Court of Law; established, re-established, monumented, re-monumented, recovered, found as expressed below:

NOTE: Not more than 4 corners, all in the same town and range, may be recorded on this certificate.

A. Description of original monument and accessories and/or subsequent restoration:

**Not an original Government Corner**  
 1883 F.A. Palmer, County Surveyor, Surveyor Notes  
 Reestablished the N 1/4 Post of Section 4 by measuring from nearest Section Corner for Township to North. Set Stone with One Flat side both on oval side North  
 1920, R.D. McNutt,  
 Stone  
 Cedar 6" Northeast 59.0 feet  
 maple 10" Northwest 58.0 feet  
 July 1, 1925, Michigan State Highway Dept., M-43, Project 11  
 Corner not found  
 March 29, 1937, R.D. McNutt  
 119.8 feet East of South Boundary 33 and 34 Ferris Township  
 Iron Bar  
 Maple 15" Northeast 36.5 feet  
 Maple 24" Northwest 41.9 feet  
 Montcalm County Road Commission, No Date Given  
 Iron Pipe 119.8 feet East of 33-34 T11N R5W  
 Maple 15" Northeast 36.5 feet  
 Maple 24" Northwest 41.9 feet  
 December 8, 1965, Merrill Hunter, RLS  
 Found 3/4" Pipe Deep raised with 1/2" rod  
 February 23, 1990 W.G. Tingley, #30104  
 Found 1-1/2" Iron Bar  
 1-1/2" Iron Bar West 119.35 feet  
 Westerly leg Road Sign, North 29.3 feet  
 Set nail Eastside Guy Pole N45°E 45.6 feet  
 Set Nail Westside Power Pole S40°E 75.5 feet

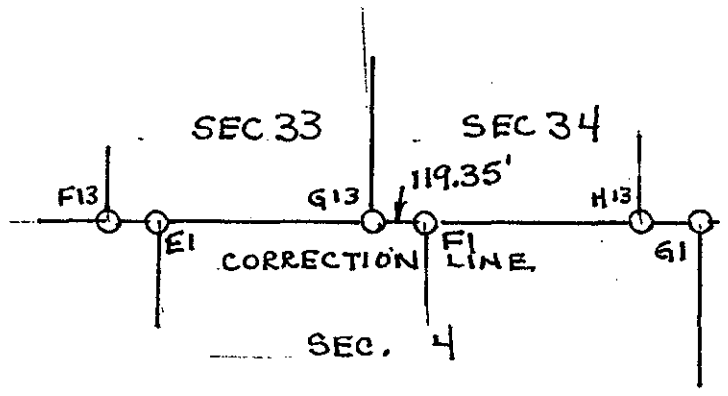

1	A	B	C	D	E	F	G	H	I	J	K	L	M
2	6	5	4	3	2	1							
3													
4	7	8	9	10	11	12							
5													
6	18	17	16	15	14	13							
7													
8	19	20	21	22	23	24							
9													
10	30	29	28	27	26	25							
11													
12	31	32	33	34	35	36							
13													

B. Description of corner evidence found and/or method applied in restoring or reestablishing corner:

Found 1-1/2" Iron Bar in Monument Box 119.35 East of Section Corner 33 & 34, T11N-R5W

C. Description of monument for corner and accessories established to perpetuate position of the corner:

Set Remonument Corner over 1-1/2" Bar in Monument Box.  
 Westerly leg of Traffic Sign North 29.3 feet  
 Nail in Eastside Telephone Pole N45°E 45.36 feet  
 Nail in Westside Telephone Pole S40°E 75.34 feet  
 Nail in Northside Power Pole S70°W 51.55 feet


ACCEPTED BY THE MONTCALM COUNTY SURVEY PEER BOARD AS THE OFFICIAL CORNER UNDER MICHIGAN PUBLIC ACT 345 OF 1990 AT A MEETING HELD 10/18/96

*William Tingley*  
 William Tingley, PS, Chairman

This position not established by original government surveyors. This monument is accepted as the best available evidence of the position of the corner.

Signed by *William Tingley*

Surveyor's Michigan License No. 30104

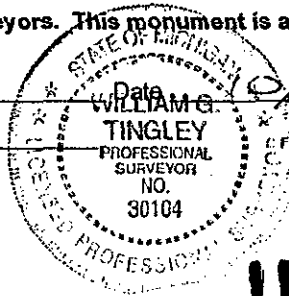

FORM APPROVED BY MICHIGAN STATE BOARD OF LAND SURVEYORS, JAN. 28, 1975  
 REVISED MAY 14, 1976  
 REVISED JAN., 1983  
 ADAPTED FOR WORD PROCESSING MARCH, 1993