SURVEY & REMONUMENTATION COMMISSION
MAY 07 1997

MONTCALM COUNTY REMONUMENTATION PROGRAM
LAND CORNER RECORDATION CERTIFICATE
Filing Requirement of Act 74, Mich. P.A. 1970

For corners in Montcalm (County) #

Located In: Crystal Township

Corner Code

STATE OF MICHIGAN
MONTCALM COUNTY
RECORDED

11/14/1996 4:03:03 PM

VIRGINIA L. KNEPPER
REGISTER OF DEEDS

Register of Deeds Stamp & File Number

1. Public Land Survey Sec 3 T 10 N R 5 W H-1, N 1/4
   T____ R____
   T____ R____
   T____ R____
2. Property Controlling S____ T____ R____
   in Section S____ T____ R____
3. Miscellaneous S____ T____ R____
   Property in Sec. S____ T____ R____
4. Lot No. _____, Recorded Plat _____
5. Private Claims _____

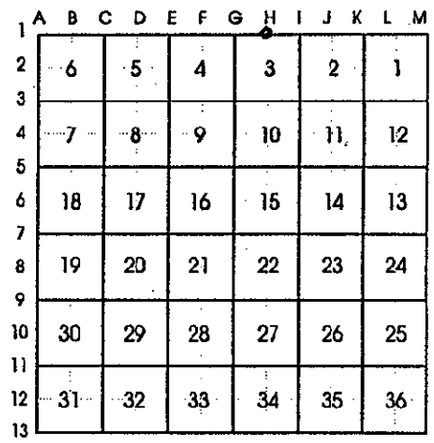

I, William Tingley a field survey on March 24 1995, do hereby certify that under requirements of P.A. 74, Michigan P.A. of 1970, the corner points mentioned in lines 1 and 2 above were in conformance with regulations and rules therefore as required in the current manual of survey instructions of the United States Department of the Interior, Bureau of Land Management or by a decree of a Court of Law and/or that the corner points mentioned in lines 3, 4 and 5 above were in conformance with the rules of the Michigan Board of Land Surveyors or by a Decree of a Court of Law; established, re-established, monumented, re-monumented, recovered, found as expressed below:

NOTE: Not more than 4 corners, all in the same town and range, may be recorded on this certificate.

A. Description of original monument and accessories and/or subsequent restoration:

1882, F.A. Palmer, County Surveyor, GLO Notes
Established N 1/4 Post and made new bearing tree
Black Ash 28" S19°E 53 links
Field Book, 10-5, Page 36-37 (missing)
Michigan State Highway Department, M-43, Project 11, Station 511 and 22, N 1/4 3-10-5
1935, R.D. McNutt, County Surveyor (Index Cards)
Found Wooden Stake
Poplar 24" Southeast 42.5 feet
Poplar 24" Southeast 31.0 feet
February 23, 1990, W.G. Tingley, #30104
Set Railroad Spike on straight line using GLO distances between I-1 T10N-R5W, J-13 T11N-R5W to east and G-13 T11N-R5W, F-1 T10N-R5W to West
Railroad Spike West 114.78 feet

B. Description of corner evidence found and/or method applied in restoring or reestablishing corner:

Found 1/2" Bolt in Monument Box 114.84 feet East of Remonumentation Corner in Monument Box at midpoint of line between Northeast and Northwest Section corners (Section 3)

ACCEPTED BY THE MONTCALM COUNTY SURVEY PEER GROUP AS THE OFFICIAL CORNER UNDER MICHIGAN PUBLIC ACT 345 OF 1990 AT A MEETING HELD 10/8/96

William Tingley, PS, Chairman

C. Description of monument for corner and accessories established to perpetuate locating the position of the corner:

Set Remonumentation Corner over Bolt

Nail and Tag in 6" Cedar Post	N40°E	40.48 feet
4" Maple (no nail)	N30°W	36.64 feet
Nail and Tag in 8" Box Elder	N55°W	61.56 feet
Center of Tope of 4" Steel Pipe (Gas line marker)	N65°W	119.72 feet
Remonumentation Corner	West	114.84 feet

This position not established by original government surveyors. This monument is accepted as the best available evidence of the position of the corner.

Signed by William Tingley Date 10/8/ , 1996

Surveyor's Michigan License No. 30104

STATE OF MICHIGAN
WILLIAM G. TINGLEY
PROFESSIONAL SURVEYOR
NO. 30104
PROFESSIONAL SURVEYOR

FORM APPROVED BY MICHIGAN STATE BOARD OF LAND SURVEYORS, JAN. 28, 1971
REVISED MAY 14, 1975
REVISED JAN., 1983
ADAPTED FOR WORD PROCESSING MARCH, 1993

LIBER 3 PAGE 303