

**SURVEY & REMONUMENTATION**

MAR 11 1998

**MONTCALM COUNTY REMONUMENTATION PROGRAM**

**LAND CORNER RECORDATION CERTIFICATE**

Filing Requirement of Act 74, Mich. P.A. 1970

STATE OF MICHIGAN  
MONTCALM COUNTY  
RECORDED

26 Dec 1997, 3:41:37 PM

LORI A. WILSON  
REGISTER OF DEEDS

For corners in **SECTION**

Montcalm  
# \_\_\_\_\_  
(County)

Located In: \_\_\_\_\_ Corner Code \_\_\_\_\_

1. Public Land Survey	Sec 35	T 10N	R 5W	J-13, S 1/4
		T	R	_____
		T	R	_____
		T	R	_____
		T	R	_____
2. Property Controlling in Section	S	T	R	_____
	S	T	R	_____
3. Miscellaneous Property in Sec.	S	T	R	_____
	S	T	R	_____

Register of Deeds Stamp & File Number

4. Lot No. \_\_\_\_\_, Recorded Plat \_\_\_\_\_  
5. Private Claims \_\_\_\_\_

I, William Tingley a field survey on \_\_\_\_\_ do hereby certify that under requirements of P.A. 74, Michigan P.A. of 1970, the corner points mentioned in lines 1 and 2 above were in conformance with regulations and rules therefore as required in the current manual of survey instructions of the United States Department of the Interior, Bureau of Land Management or by a decree of a Court of Law and/or that the corner points mentioned in lines 3, 4 and 5 above were in conformance with the rules of the Michigan Board of Land Surveyors or by a Decree of a Court of Law; established, re-established, monumented, re-monumented, recovered, found as expressed below:

1	A	B	C	D	E	F	G	H	I	J	K	L	M
2		6	5	4	3	2	1						
3													
4		7	8	9	10	11	12						
5													
6		18	17	16	15	14	13						
7													
8		19	20	21	22	23	24						
9													
10		30	29	28	27	26	25						
11													
12		31	32	33	34	35	36						
13													

NOTE: Not more than 4 corners, all in the same town and range, may be recorded on this certificate.

A. Description of original monument and accessories and/or subsequent restoration:  
1831, Robert Clark, Jr., Deputy Surveyor, GLO Notes

Quarter Section Post  
Beech 7" N17°E 10 links  
Sugar 17" N37°W 14 links

1968, Salisbury and Saunders, Survey of Consumers Power Company right-of-way

Computed 1/4 Corner at Midpoint (not set)  
1990, W.G. Tingley #30104, Survey #90341

Set 1/2" Iron and Cap at midpoint of line between Southeast and Southwest Corners of Section 35  
Iron and Cap (N1/4 Section 2, 9-5) West 13.86 feet  
Nail in North side 20" Oak N80°E 13.95 feet  
Nail in North side 10" Oak N70°W 22.50 feet  
Nail in North side 14" Beech S20°W 26.85 feet

1994, W.G. Tingley, #30104, Survey #94049


Same data as 1990

B. Description of corner evidence found and/or method applied in restoring or reestablishing corner:

Found cap and iron set previously

ACCEPTED BY THE MONTCALM COUNTY SURVEY PEER GROUP AS THE OFFICIAL CORNER UNDER MICHIGAN PUBLIC ACT 345 OF 1990 AT A MEETING HELD 7-30-97

William Tingley, PS, Chairman

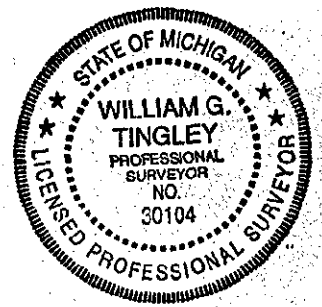

C. Description of monument for corner and accessories established to perpetuate locating the position of the corner:

Set Remonumentation Corner over Iron and Cap

Iron and Cap (N1/4 Section 2, 9-5) West 13.86 feet  
Nail in North side 20" Oak N80°E 13.95 feet  
Nail in North side 10" Oak N70°W 22.50 feet  
Nail in North side 14" Beech S20°W 26.85 feet

This corner is accepted as a careful and faithful perpetuation of the position of the original corner.

Signed by William G. Tingley Date 7/30/ 1997

Surveyor's Michigan License No. 30104

FORM APPROVED BY MICHIGAN STATE BOARD OF LAND SURVEYORS, JAN. 28, 1971  
REVISED MAY 14, 1975  
REVISED JAN., 1983  
ADAPTED FOR WORD PROCESSING MARCH, 1983