

SURVEY & REMONUMENTATION

MAY 07 1997

COMMISSION

**MONTCALM COUNTY REMONUMENTATION PROGRAM
LAND CORNER RECORDATION CERTIFICATE
Filing Requirement of Act 74, Mich. P.A. 1970**

For corners in Montcalm Located In: _____ Corner Code # _____
(County)

Crystal Township
1. Public Land Survey Sec 1 T 10 N R 5 W L-1, N 1/4
T _____ R _____
T _____ R _____
T _____ R _____

2. Property Controlling in Section S _____ T _____ R _____
S _____ T _____ R _____

3. Miscellaneous Property in Sec. S _____ T _____ R _____
S _____ T _____ R _____

4. Lot No. _____, Recorded Plat _____

5. Private Claims _____

STATE OF MICHIGAN
MONTCALM COUNTY
RECORDED

11/14/1996 4:06:15 PM

VIRGINIA L. KNEPPER
REGISTER OF DEEDS

Register of Deeds Stamp & File Number


	A	B	C	D	E	F	G	H	I	J	K	L	M
1													
2	6	5	4	3	2	1							
3													
4	7	8	9	10	11	12							
5													
6	18	17	16	15	14	13							
7													
8	19	20	21	22	23	24							
9													
10	30	29	28	27	26	25							
11													
12	31	32	33	34	35	36							
13													

I, William Tingley a field surveyor on March 31, 1995, do hereby certify that under requirements of P.A. 74, Michigan P.A. of 1970, the corner points mentioned in lines 1 and 2 above were in conformance with regulations and rules therefore as required in the current manual of survey instructions of the United States Department of the Interior, Bureau of Land Management or by a decree of a Court of Law and/or that the corner points mentioned in lines 3, 4 and 5 above were in conformance with the rules of the Michigan Board of Land Surveyors or by a Decree of a Court of Law; established, re-established, monumented, re-monumented, recovered, found as expressed below:

NOTE: Not more than 4 corners, all in the same town and range, may be recorded on this certificate.

A. Description of original monument and accessories and/or subsequent restoration:
This is not an Original Government Corner
September 16 and 17, 1879, F.A. Palmer, County Surveyor, Book 1, Page 176 and 177
Established N 1/4 Post by measuring 150-1/2 links East from Section Corner Township to North Montcalm County Road Commission Records
150.5 links East of Southeast Corner Ferris Township
July 1, 1925, Michigan Department of Highway: M-43 Project 11
N 1/4 Corner 1 T10N-R5W at Station 626+81.4
December 12, 1979, Jerry Jones #19838 (LCRC, Liber 1 Page 498 and Liber 485, page 501)
Set 3/4" Pipe Equidistance on line between K-1 (Northeast Corner) and M-1 (Northwest Corner)
1" Foot concrete post Southwest 66.30 feet
Center 6" Thornapple South 52.50 feet
September 18, 1992, W.G. Tingley #30104
Found Boat Spike in Monument Box
Center 1 foot Concrete Post Southwest 66.30 feet
Center 6" Thornapple South 52.50 feet

B. Description of corner evidence found and/or method applied in restoring or reestablishing corner:
Found Boat Spike in Monument Box 2634.60 feet from Northeast Corner of Section 1 per J. Jones Survey, Liber 52, Page 501 and 2635.01 feet from Northwest Corner of Section 1 per W.G. Tingley Survey

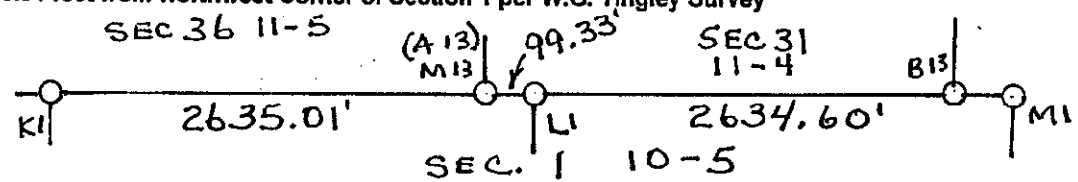

C. Description of monument for corner and accessories established to perpetuate locating the position of the corner:
Set Remonumentation Corner in Monument Box over Boat Spike on Township Line between A-13 and B-13, T11N-R4W
1 foot square post (concrete) S45°W 66.30 feet
Nail and Tag in Eastside 5" Locust N05°W 66.22 feet
Nail and Tag in Northside Power Pole S68°W 197.33 feet
Nail and Tag in Westside 20" Locust N50°W 132.28 feet
6" Locust S05°E 52.5 feet
Township Corner West 99.33 feet


ACCEPTED BY THE MONTCALM COUNTY SURVEY PEER GROUP AS THE OFFICIAL CORNER UNDER MICHIGAN PUBLIC ACT 345 OF 1990 AT A MEETING HELD 10/8/96

WGT
William Tingley, PS, Chairman

This corner not established by original government surveyors. This monument is accepted as the best available evidence of the position of the corner.

Signed by William Tingley Date 10/8, 1996

Surveyor's Michigan License No. 30104

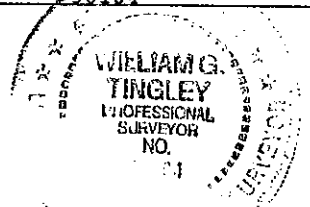

FORM APPROVED BY MICHIGAN STATE BOARD OF LAND SURVEYORS, JAN. 28, 1971
REVISED MAY 14, 1976
REVISED JAN., 1983
ADAPTED FOR WORD PROCESSING MARCH, 1993

LIBER 3 PAGE 308