

SURVEY & REMONUMENTATION

MAY 07 1997

COMMISSION

**GRATIOT COUNTY REMONUMENTATION PROGRAM
MONTCALM COUNTY REMONUMENTATION PROGRAM
LAND CORNER RECORDATION CERTIFICATE
Filing Requirement of Act 74, Mich. P.A. 1970**

For corners in Montcalm (County) Located In: Crystal Township/Bloomer/ Corner Code #

1. Public Land Survey Sec 36 T 10N R 5W M-13 SE Corner
 T 9N R 5W M-1 NE Corner
 T 10N R 4W A-13 SW Corner
 T 9N R 4W A-1 NW Corner

2. Property Controlling in Section S _____ T _____ R _____
 S _____ T _____ R _____

3. Miscellaneous Property in Sec. S _____ T _____ R _____
 S _____ T _____ R _____

4. Lot No. _____, Recorded Plat _____

5. Private Claims _____

STATE OF MICHIGAN
MONTCALM COUNTY
RECORDED

11/14/1996 4:03:16 PM

VIRGINIA L. KNEPPER
REGISTER OF DEEDS

GRATIOT

Register of Deeds Stamp & File Number

	A	B	C	D	E	F	G	H	I	J	K	L	M
1													
2	6	5	4	3	2	1							
3													
4	7	8	9	10	11	12							
5													
6	18	17	16	15	14	13							
7													
8	19	20	21	22	23	24							
9													
10	30	29	28	27	26	25							
11													
12	31	32	33	34	35	36							
13													


I, William Tingley a field surveyor on June 30, 1995 do hereby certify that under requirements of P.A. 74, Michigan P.A. of 1970, the corner points mentioned in lines 1 and 2 above were in conformance with regulations and rules therefore as required in the current manual of survey instructions of the United States Department of the Interior, Bureau of Land Management or by a decree of a Court of Law and/or that the corner points mentioned in lines 3, 4 and 5 above were in conformance with the rules of the Michigan Board of Land Surveyors or by a Decree of a Court of Law, established, re-established, monumented, re-monumented, recovered, found as expressed below:

NOTE: Not more than 4 corners, all in the same town and range, may be recorded on this certificate.

- A. Description of original monument and accessories and/or subsequent restoration:
- 1831, Robert Clark, Jr., Deputy Surveyor, GLO Notes
West on South Boundary, Section 31, T10N-R5W
75.50 chains - intersect West boundary of the end of 5 miles 79 chains, 16 links
Sugar 16" S42-1/2°E 25 links
Sugar 14" N21-1/2°E 21 links
North on East Boundary Section 1, T9N-R5W, 79.16 chains - Intersect North Boundary at end of 5 miles
75 chains, 50 links
 - 1869, D.W. Altenburg, Gratiot County Surveyor, Liber B, Page 16, Record of Minutes of Survey
Post 3" x 3"
Pine Stump 40" N32-1/2°E 50 links
Beech 16" S40-1/2°E 61 links
 - 1891, Edward Jones, County Surveyor
Pine Stump 42" N25-1/4°E 76 links
Pine Stump 42" S66°E 102 links
 - 1935, R.D. McNutt, County Surveyor, Record Cards
Found stone
Double Wild Cherry Southeast 47.0 feet
 - 1968, Salisbury and Saunders; Surveyors in Consumers Power Company Survey
Found stone
28" White oak S55°E 28.4 feet
Telephone Pole S45°W 40.8 feet
Telephone Pole N45°W 90.7 feet

ACCEPTED BY THE MONTCALM COUNTY SURVEY PEER GROUP AS THE OFFICIAL CORNER UNDER MICHIGAN PUBLIC ACT 345 OF 1990 AT A MEETING HELD 10/8/96

WGT
William Tingley, PS, Chairman

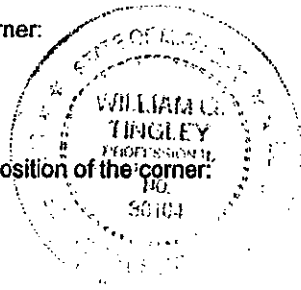

- B. Description of corner evidence found and/or method applied in restoring or reestablishing corner:
Found rerod at surface
Found 3/4" pipe below rerod
Found stone on Eastside of rerod (point end up 0.8' x 0.8' x 1.3')
Found crockery around stone
- C. Description of monument for corner and accessories established to perpetuate locating the position of the corner:
Set remonumentation corner in place of stone (left stone beside)
Found nail in Power Pole S35°W 89.25 feet
Found nail in 23" Hickory S30°E 90.37 feet
Centerline of 3" Oak N55°E 90.40 feet
Top, Center of Cable Riser Box West 24.95 feet

This corner is accepted as a careful and faithful perpetuation of the position of the original corner.

Signed by William Tingley Date 10/8, 1996

Surveyor's Michigan License No. 30104