


GOV'T. MONUMENT WITNESSES RECORD

Form 280
(Rev. 3/60)

T. 10 N R. 6 & ⑦ W

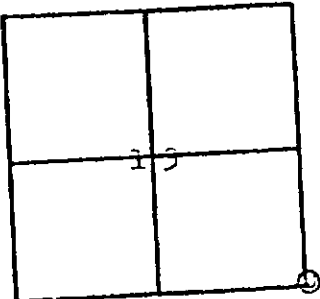

WITNESSES

N 62°W	51.65'	P.P.
S 28°E	68.96'	13" Ash
N 66°E	53.93'	T.P.

SE Sec. Cor.

SEC. NO. 13

Montcalm County
DESCRIPTION

Sec. Cor. common to Sec's 18 & 19
 T 10 N R 6 W and Sec's 13 & 24
 T 10 N R 7 W.
 Found 3/4" iron bar in Mon box.

6W = A7
 7W = M7
 1-1-62
 DATE

MICHIGAN STATE HIGHWAY DEPARTMENT

Leht A. Koivisto
 SURVEY CHIEF