
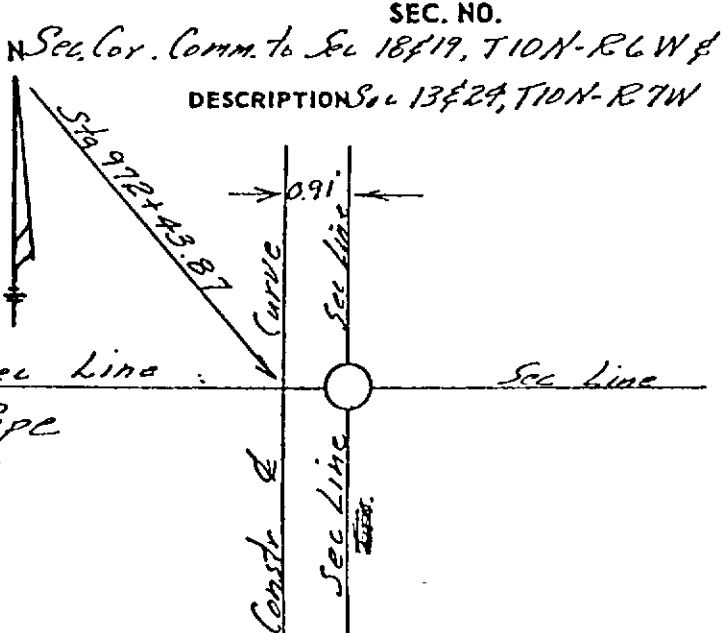


GOV'T. MONUMENT WITNESSES RECORD


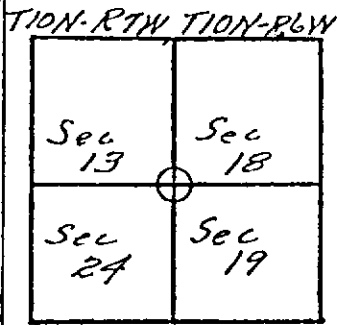

SEC. NO.

Sec. Cor. Comm. to Sec 18 & 19, T10N-R6W & Sec 13 & 24, T10N-R7W

DESCRIPTION

WITNESSES

Sec. Cor. 1" Pipe
in Mon. Box

Sta 972+43.87

Proj. 59051 B

P.T. Walker

2-2-67

MICHIGAN STATE HIGHWAY DEPARTMENT

SURVEY CHIEF

DATE