

JAN 20 2000

MONTCALM COUNTY REMONUMENTATION PROGRAM

LAND CORNER RECORDATION CERTIFICATE

Filing Requirement of Act 74, Mich. P.A. 1970

SECTION

For corners in


Montcalm (County)

Located In:

Evergreen Township

Corner Code #

1. Public Land Survey	Sec 4	T 10	R 6	G-1, Cor 3&4
		T	R	
		T	R	
		T	R	
2. Property Controlling in Section	S	T	R	
	S	T	R	
3. Miscellaneous Property in Sec.	S	T	R	
	S	T	R	

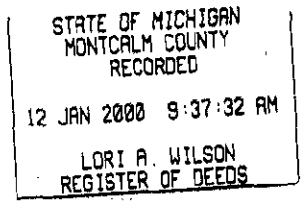

Register of Deeds Stamp & File Number

- 4. Lot No. _____, Recorded Plat _____
- 5. Private Claims _____

I, William G. Tingley a field survey on September 1, 1995, do hereby certify that under requirements of P.A. 74, Michigan P.A. of 1970, the corner points mentioned in lines 1 and 2 above were in conformance with regulations and rules therefore as required in the current manual of survey instructions of the United States Department of the Interior, Bureau of Land Management or by a decree of a Court of Law and/or that the corner points mentioned in lines 3, 4 and 5 above were in conformance with the rules of the Michigan Board of Land Surveyors or by a Decree of a Court of Law; established, re-established, monumented, re-monumented, recovered, found as expressed below:

1	A	B	C	D	E	F	G	H	I	J	K	L	M
2	6	5	4	3	2	1							
3													
4	7	8	9	10	11	12							
5													
6	18	17	16	15	14	13							
7													
8	19	20	21	22	23	24							
9													
10	30	29	28	27	26	25							
11													
12	31	32	33	34	35	36							

ACCEPTED BY THE MONTCALM COUNTY SURVEY PEER GROUP AS THE OFFICIAL CORNER UNDER MICHIGAN PUBLIC ACT 345 OF 1990 AT A MEETING HELD 11/23/99

WGT
William Tingley, PS, Chairman

NOTE: Not more than 2 corners, all in the same town and range, may be recorded on this certificate.

- A. Description of original monument and accessories and/or subsequent restoration:
- 1838, Noah Brookfield, Deputy Surveyor, GLO Notes
Correction line - Set Post Corner of 3 and 4
Sugar 6" S88°W 12 links
Beech 8" S14°E 17 links
 - July 1889, Red County Survey Book in Courthouse, Page 62
3 & 4 N Bdy reset equal distance between Cor. 2 & 3 and Cor. 4 & 5
NBT Elm 20" S43 3/4°W 119 links
 - 1902, H.M. Caukin, County Survey, Book 1, Survey Records Page 230
Axle Skein as reset by J.E. Youdan about 1898, Book 3 of Survey Records, Page 62 and 63 as reset by Youdan about 1898
 - July 1912, Red County Survey in Courthouse, Page 72.
3 + 4 N.bdy. - Found stone point up in ditch on N. side of Highway set by J.E.Y. drove gaspipe 1 1/4" x 38" on E. side.
 - 1925, Michigan State Highway Department Plans, State Trunk line 43, Project 5 Gas Pipe
Elm 12" S20°W 46.3 feet
Swamp Oak 8" S20°E 46.4 feet
 - R.D. McNutt, County Surveyor, Index cards
No date E.D. Youdan
Gas Pipe 1-1/4" x 38 feet and stone
M.C.H. (?), gas pipe
Elm 12" S20°W 46.3 feet
S. Oak 8" S20°E 46.4 feet

(Continued on back...)



- B. Description of corner evidence found and/or method applied in restoring or reestablishing corner:
Searched at apparent location of corner and found 1" solid iron in monument box 148.17 feet east of H-13, and 12.50 feet South centerline road. This corner is accepted as the best available evidence of the position of the original corner.
- C. Description of monument for corner and accessories established to perpetuate locating the position of the corner:
G-01, Town 10 North, Range 06 West, Evergreen Township, Montcalm County, Set remonumentation monument over 1" iron in Mon box.
Witnessed By:
Set nail and tag in East side 14" Elm S30°W 63.12 feet
Set nail and tag in West side 14" Oak S35°E 55.14 feet
Set nail and tag in South side Power Pole N60°E 86.13 feet
Centerline road South 12.5 feet
G-01 is 148.17 feet east of H-13 T11N-R06W (not an approved remon corner).



LIBER 4 PAGE 202

Bearings given are magnetic. Standard Remonumentation consists of a berntsen stainless steel 30" x 2 3/8" pipe with brass cap stamped "MONTCALM COUNTY REMONUMENTATION", P.S. 30104

Signed by William G. Tingley Date 01/11/00

Surveyor's Michigan License No. 30104

- 7. June 18, 1940, County Road Commission Records
 Found Gas Pipe, brought to surface with wood stake

Elm	12"	Southwest	48.4 feet
Basswood	10"	Southwest	93.1 feet
Oak	24"	Southeast	75.0 feet



- 8. Court House record (list), no date
Same as 1925 State Highway
- 9. G.M. Stevenson, card file, No Date (about 1970)
Gas pipe

Elm	12"	S20°W	46.3 feet
Spanish Oak	8"	S20°E	46.4 feet
- 10. May 15, 1974, Vincent P. McMahon #5132, Liber 481, Page 535.
Found nail in centerline of Stanton Road

Gas main sign	S60°E	43.55'
Ang. Post	S45°W	45.11'
Power Pole	N60°E	94.57'

- 11. Nov. 06, 1975, George M. Stevenson, Jr. #13600, L.C.R.C., Liber 1, Page 359 (for H-13)
Found 1 1/4" pipe; 148.75 ft. West of the Northwest corner of Sec. 3, T10N - R06W.
- 12. No other references found.

RECORDS SECTION
 JAN 20 2000