

**MONTCALM COUNTY REMONUMENTATION PROGRAM  
LAND CORNER RECORDATION CERTIFICATE  
Filing Requirement of Act 74, Mich. P.A. 1970**

DEC 19 2000

SECTION

For corners in  
Montcalm  
(County)

Located In:  
Eureka Township

Corner Code #

- |                                    |               |           |
|------------------------------------|---------------|-----------|
| 1. Public Land Survey Sec. 6       | T 09 N R 08 W | A-01      |
|                                    | T 10 R 08     | A-13      |
|                                    | T 09 R 09     | M-01 KENT |
|                                    | T 10 R 09     | M-13 KENT |
| 2. Property Controlling in Section | S T R         |           |
|                                    | S T R         |           |
| 3. Miscellaneous Property in Sec.  | S T R         |           |
|                                    | S T R         |           |

STATE OF MICHIGAN  
MONTCALM COUNTY  
RECORDED  
7 NOV 2000 9:12:57 AM  
LORI A. WILSON  
REGISTER OF DEEDS

Register of Deeds Stamp & File Number

4. Lot No. \_\_\_\_\_, Recorded Plat \_\_\_\_\_  
5. Private Claims \_\_\_\_\_

A	B	C	D	E	F	G	H	I	J	K	L	M
1												
2	6	5	4	3	2	1						
3												
4	7	8	9	10	11	12						
5												
6	18	17	16	15	14	13						
7												
8	19	20	21	22	23	24						
9												
10	30	29	28	27	26	25						
11												
12	31	32	33	34	35	36						
13												

I, William G. Tingley, in a field survey on May 8, 2000 do hereby certify that under requirements of P.A. 74, Michigan P.A. of 1970, the corner points mentioned in lines 1 and 2 above were in conformance with regulations and rules therefore as required in the current manual of survey instructions of the United States Department of the Interior, Bureau of Land Management or by a decree of a Court of Law and/or that the corner points mentioned in lines 3, 4 and 5 above were in conformance with the rules of the Michigan Board of Land Surveyors or by a Decree of a Court of Law; established, re-established, monumented, re-monumented, recovered, found as expressed below:

**NOTE: Not more than 2 corners, all in the same town and range, may be recorded on this certificate.**

**A. Description of original monument and accessories and/or subsequent restoration:**

- May 28, 1837, Noah Brookfield, Deputy Surveyor, GLO notes, West on south side section 31 T10N R08W**  
Intersect West boundary 3.40 N of Post, Set Post cor of T's 9 & 10 N R's 8 & 9 W 80.37 chains.  
Y. Oak 9" S72°E 85 links (56.10 feet)  
Do 10" N78°W 1.32 chains (87.12 feet)
- June 13, 1974, Vincent P. McMahon, # 5132, Certificate of Survey**  
Iron in asphalt  
St. sign S45°W 45.00 feet  
Stop sign S40°E 50.85 feet  
Conc mon North 34.05 feet
- July 18, 1980, Richard J. Crater, # 16924, LCRC Liber 1 Page 518**  
R.R. spike over 1/2" pipe  
Tele. cable riser N45°E 47.50 feet  
P.P. N50°W 78.40 feet  
Plat mon. S40°E 74.60 feet  
Pine 11" N40°W 66.45 feet
- November 09, 1982, Vincent P. McMahon, # 5132, Certificate of Survey Job # VS 11982**  
Section corner 1" iron in blacktop  
Street sign S45°W 45.00 feet  
Stop sign S40°E 50.85 feet  
Concrete monument North 34.00 feet



ACCEPTED BY THE MONTCALM COUNTY SURVEY PEER GROUP AS THE OFFICIAL CORNER UNDER MICHIGAN PUBLIC ACT 345 OF 1990 AT A MEETING HELD 10/11/00

WGT  
William Tingley, PS, Chairman

(Continued on back)

- B. Description of corner evidence found and/or method applied in restoring or reestablishing corner:**  
Searched the apparent location of the corner. Found Kent Co. monument.
- C. Description of monument for corner and accessories established to perpetuate locating the position of the corner:**  
Kent Co. Mon.  
Fnd N/T W/S 12" Cherry N50°E 35.30 feet  
Fnd N/T SE/S 13" Pine S43°E 60.50 feet  
Fnd N/T SW/S P.P. N57°W 78.65 feet  
Fnd N/T E/S P.P. N07°W 30.00 feet  
Fnd conc. mon. N05°E 34.10 feet



LIBER 4

PAGE 287

This corner is accepted as the best available evidence of the position of the original corner.

Bearings given are magnetic. Standard remonumentation pipe consists of a Berntsen stainless steel 2 3/8" x 30" pipe with a brass cap stamped "MONTCALM COUNTY REMONUMENTATION, P.S. # 30104."

Signed by William G. Tingley Date 10/11/00  
Surveyor's Michigan License No. 30104



6. December 7, 1987, John C. Bueche, # 13027, LCRC  
 Replaced rerod with standard Kent Co. Mon. (Harrison 4" x 30")
- |                     |       |            |
|---------------------|-------|------------|
| N/T SE/S P.P.       | S30°W | 83.14 feet |
| N/T E/S 30" Walnut  | N35°W | 59.30 feet |
| N/T S/S 8" Walnut   | S70°E | 35.65 feet |
| N/T SW/S 16" Walnut | S45°E | 59.79 feet |
| N/T SE/S 8" Walnut  | S60°W | 84.27 feet |
| N/T W/S 8" Walnut   | N30°E | 68.49 feet |
- 2' ± N CL road W, 4' ± E CL road N-S

UMENTATIO


DEC 19 2000

7. November 12, 1990, William G. Tingley, # 30104, LCRC Liber 2 Page 331  
 Found Kent Co. Mon.
- |                    |          |            |
|--------------------|----------|------------|
| Rd. name sign post | S45°W    | 58.30 feet |
| South leg rd sign  | S80°E    | 24.40 feet |
| 1/2" rerod         | S23°34'E | 17.75 feet |

SECTION

8. November 13, 1990, William G. Tingley, # 30104, Certificate of Survey Job # 90488  
 Fnd KC mon.
- |                   |          |            |
|-------------------|----------|------------|
| Rd name post sign | S45°W    | 58.30 feet |
| S. leg rd. sign   | S80°E    | 24.44 feet |
| 1/2" rerod        | S23°34'E | 17.75 feet |

9. September 27, 1999, Randy Kolehouse # 25854, Kent County Remon LCRC # 11577  
 Found a Standard Kent County Monument 2" +/- north of MacClain Street (bit) running west of Montcalm Avenue (bit) running north and south per LCRC #4532 and # 7255 as set by John Bueche in place of a rerod he found which checked LCRC # 1264 and LCRC Liber 001 Page 518 (Montcalm County)
- |                                   |       |               |
|-----------------------------------|-------|---------------|
| Nail/KC Remon tag SE/S PP         | S30°W | 83.17 feet    |
| Nail/KC Remon tag E/S walnut 30"  | N35°W | 59.22 feet    |
| Nail/KC Remon tag S/S walnut 10"  | S70°E | 35.80 feet    |
| Nail/KC Remon tag SW/W walnut 16" | S45°E | 60.09 feet    |
| Nail/KC Remon tag W/S walnut 10"  | N30°E | 68.36 feet    |
| C/L Bit road running west         | South | 2.00 +/- feet |
| C/L bit road running N-S          | East  | 4.00 +/- feet |

 

