

**SURVEY &  
REMONUMENTATION**

SEP 12 1995

COMMISSION

**MONTCALM COUNTY REMONUMENTATION PROGRAM**

**LAND CORNER RECORDATION CERTIFICATE**

Filing Requirement of Act 74, Mich. P.A. 1970

For corners in

Montcalm (County)	Located In:	Corner Code #
1. Public Land Survey	Sec 9 T <u>10</u> R <u>8</u>	<u>E-5, SW Corner</u>
	T _____ R _____	_____
	T _____ R _____	_____
	T _____ R _____	_____
2. Property Controlling in Section	S _____ T _____ R _____	_____
	S _____ T _____ R _____	_____
3. Miscellaneous Property in Sec.	S _____ T _____ R _____	_____
	S _____ T _____ R _____	_____

STATE OF MICHIGAN  
MONTCALM COUNTY  
RECORDED

10 AUG 95 3:34 P.M.

VIRGINIA L. KNEPPER  
REGISTER OF DEEDS  
Register of Deeds Stamp & File Number

4. Lot No. \_\_\_\_\_ Recorded Plat \_\_\_\_\_  
5. Private Claims \_\_\_\_\_

I, William Tingley a field surveyor on December 3, 1994, do hereby certify that under requirements of P.A. 74, Michigan P.A. of 1970, the corner points mentioned in lines 1 and 2 above were in conformance with regulations and rules therefore as required in the current manual of survey instructions of the United States Department of the Interior, Bureau of Land Management or by a decree of a Court of Law and/or that the corner points mentioned in lines 3, 4 and 5 above were in conformance with the rules of the Michigan Board of Land Surveyors or by a Decree of a Court of Law, established, re-established, monumented, re-monumented, recovered, found as expressed below:

	A	B	C	D	E	F	G	H	I	J	K	L	M
1													
2	6	5	4	3	2	1							
3													
4	7	8	9	10	11	12							
5													
6	18	17	16	15	14	13							
7													
8	19	20	21	22	23	24							
9													
10	30	29	28	27	26	25							
11													
12	31	32	33	34	35	36							
13													

NOTE: Not more than 4 corners, all in the same town and range, may be recorded on this certificate.

A. Description of original monument and accessories and/or subsequent restoration:

March 26, 1838, Noah Brookfield, Deputy Surveyor, GLO Notes

Set Post

White Oak 18" S72°E 12 links  
Ironwood 10" N72°W 20 links

1878, H.M. Caulkins, Field Notes, 10-8

New Bearing Tree

White Oak 6" N73°W 9-1/2 links  
Pine Stump 28" N45°E 43 links

August 1884, F.A. Palmer, County Surveyor, Book 1, Page 327

Found stone and bearing trees from 1878

1914, R.D. McNutt, Field Book

Plow Point

Double pine stump -- rear stump 30 inches S26°W 70 links

August 1919, R.D. McNutt, County Surveyor, Field Book Page 12

Pine Stake

B. Oak 6" S46°E 61 links

1954, G. M. Stevenson from R.D. McNutt's Index Cards, 10-8 (40)

Found Corner, placed Iron

Found Old bearing tree: B. Oak 25" Southeast 40 feet  
White Oak 10" Northeast 45.2 feet  
Twin Oak 28" Northeast 59.8 feet  
Red Oak 5" Northwest 29.8 feet

Continued on back page .....

B. Description of corner evidence found and/or method applied in restoring or reestablishing corner:

Found 1" x 1.7 feet solid iron bar with threads on bottom below pavement surface, set in nest of stones.

Found 1/2" iron bar with 1" diameter top piece, 2.7 feet long, below 1" iron extending to approximately 4' deep into sand below fill.

C. Description of monument for corner and accessories established to perpetuate locating the position of the corner:

Set Remonumentation Corner over irons.


Found nail and Michigan Department of Transportation Tag in power pole, N45°E 40.85 feet  
Found nail and Michigan Department of Transportation Tag in railroad post, S60°W, 49.98 feet  
Found nail and Michigan Department of Transportation Tag in railroad post, S35°W, 35.18 feet  
Top center of Riser Box, S5°E 31.95 feet

This corner is accepted as a careful and faithful perpetuation of the position of the original corner.

Signed by William Tingley Date Dec 1, 1994

Surveyor's Michigan License No. 30104

ACCEPTED BY THE MONTCALM COUNTY SURVEY PEER GROUP AS THE OFFICIAL CORNER UNDER MICHIGAN PUBLIC ACT 345 OF 1990 AT A MEETING HELD 13 April 95  
William Tingley  
William Tingley, PS, Chairman

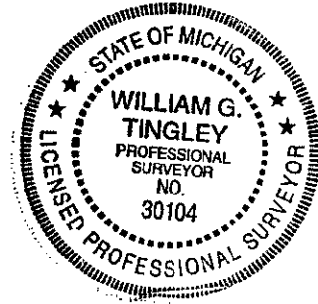

Continued from Page 1 (E-5, Southwest 9-10-8)

**Montcalm County Road Commission Files, 10-8, #61**

Twin Oak	12"	Northeast	59.80 feet
Twin Oak	18"	Northeast	69.05 feet
Triple Oak	12"	Northeast	90.55 feet
East end of culvert pipe		Northeast	33.10 feet
West end of culvert pipe		Northwest	25.45 feet

April 1986, Burt Wickham, #17639, Recorded Survey, Liber 439, Page 343

Found 1" Solid Rod

Found Nail & Tag	Northwest side Railroad Post	S60°W	50.35 feet
Found Nail & Tag	Eastside Railroad Post	S35°W	35.59 feet
Found Nail & Tag	Southeast 6" Pine	N45°E	49.75 feet

Rerod South 33.0 feet