

# SURVEY & REMONUMENTATION

FEB 19 1998

## MONTCALM COUNTY REMONUMENTATION PROGRAM

### SECTION

### LAND CORNER RECORDATION CERTIFICATE

Filing Requirement of Act 74, Mich. P.A. 1970

STATE OF MICHIGAN  
MONTCALM COUNTY  
RECORDED

26 Dec 1997 3:41:27 PM

LORI A. WILSON  
REGISTER OF DEEDS

Register of Deeds Stamp & File Number

For corners in <u>Montcalm</u> (County)	Located In:	Corner Code #
1. Public Land Survey	Sec 2 T 10N R 8W	J-1, N 1/4
2. Property Controlling in Section	S T R S T R S T R	_____ _____ _____
3. Miscellaneous Property in Sec.	S T R S T R	_____ _____

4. Lot No. \_\_\_\_\_ Recorded Plat \_\_\_\_\_  
 5. Private Claims \_\_\_\_\_

I, William Tingley a field survey on August 1st, 1997, do hereby certify that under requirements of P.A. 74, Michigan P.A. of 1970, the corner points mentioned in lines 1 and 2 above were in conformance with regulations and rules therefore as required in the current manual of survey instructions of the United States Department of the Interior, Bureau of Land Management or by a decree of a Court of Law and/or that the corner points mentioned in lines 3, 4 and 5 above were in conformance with the rules of the Michigan Board of Land Surveyors or by a Decree of a Court of Law, established, re-established, monumented, re-monumented, recovered, found as expressed below:

**NOTE:** Not more than 2 corners, all in the same town and range, may be recorded on this certificate.

A. Description of original monument and accessories and/or subsequent restoration:

Not GLO Corner

1977, G. Stevenson, Jr. #13600, Survey #2277A  
 Shows corner 2649.03 feet East of Northwest Corner and 493.55 feet East of Corner 35-36 T11N-R8W  
 June 1992, W.G. Tingley #30104, Survey No. 92194 and Field Notes  
 Set Capped Iron on tree row from G.M. Stevenson Jr. 1977 data for midpoint. Corner is 493.55 East from corner 35 and 36 11-8 (Railroad Spike)  
 Approximately 300 feet South of Centerline Tree Row South  
 Centerline E-W paved Road South 3.3 feet  
 Set Nail & Tag side 4" Poplar S45°E 57.83 feet

B. Description of corner evidence found and/or method applied in restoring or reestablishing corner:

Found 1/2" rerod with orange cap (illegible)  
 Found nail and flagging West side 17" Poplar (barely visible) S44°W 57.75 feet  
 Centerline E-W paved road South 3.3 feet

ACCEPTED BY THE MONTCALM COUNTY SURVEY PEER GROUP AS THE OFFICIAL CORNER UNDER MICHIGAN PUBLIC ACT 345 OF 1990 AT A MEETING HELD 12/10/97.

12/10 WGT  
 William Tingley, PS, Chairman

C. Description of monument for corner and accessories established to perpetuate locating the position of the corner:


Set standard remonumentation corner over rerod  
 Set nail and tag #30104 East side 17" Poplar S46°W 57.80 feet  
 Set P.K. and tag #30104 4" Poplar S77°W 91.39 feet  
 No passing sign S60°E 69.30 feet  
 Do not pass sign N83°E 68.51 feet

This position not established by original government survey.

This monument is accepted as a careful and faithful determination of the position of the corner.

Signed by William Tingley Date 12/10, 1997

Surveyor's Michigan License No. 30104

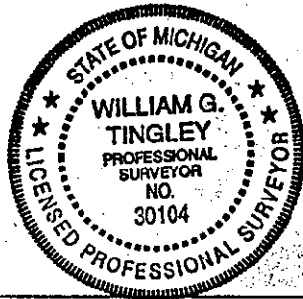

FORM APPROVED BY MICHIGAN STATE BOARD OF LAND SURVEYORS, JAN. 28, 1971  
 REVISED MAY 14, 1971  
 REVISED JAN., 1981