

SURVEY &
REMONUMENTATION

MONTCALM COUNTY REMONUMENTATION PROGRAM

SEP 12 1995

LAND CORNER RECORDATION CERTIFICATE

COMMISSION

Filing Requirement of Act 74, Mich. P.A. 1970

For corners in Montcalm Located In: _____ Corner Code # _____
(County)

1. Public Land Survey Sec. 32 T 11 R 5 D-13 S 1/4
 T _____ R _____
 T _____ R _____
 T _____ R _____

2. Property Controlling S _____ T _____ R _____
 in Section S _____ T _____ R _____

3. Miscellaneous S _____ T _____ R _____
 Property in Sec. S _____ T _____ R _____

4. Lot No. _____, Recorded Plat _____

5. Private Claims _____

STATE OF MICHIGAN
MONTCALM COUNTY
RECORDED

10 AUG 95 3:30 P.M.

VIRGINIA L. KNEPPER
REGISTER OF DEEDS

Register of Deeds Stamp & File Number

1	A	B	C	D	E	F	G	H	I	J	K	L	M
2	6	5	4	3	2	1							
3													
4	7	8	9	10	11	12							
5													
6	18	17	16	15	14	13							
7													
8	19	20	21	22	23	24							
9													
10	30	29	28	27	26	25							
11													
12	31	32	33	34	35	36							
13													


I, William Tingley a field surveyor on March 18, 1995, do hereby certify that under requirements of P.A. 74, Michigan P.A. of 1970, the corner points mentioned in lines 1 and 2 above were in conformance with regulations and rules therefore as required in the current manual of survey instructions of the United States Department of the Interior, Bureau of Land Management or by a decree of a Court of Law and/or that the corner points mentioned in lines 3, 4 and 5 above were in conformance with the rules of the Michigan Board of Land Surveyors or by a Decree of a Court of Law, established, re-established, monumented, re-monumented, recovered, found as expressed below:

NOTE: Not more than 4 corners, all in the same town and range, may be recorded on this certificate.

A. Description of original monument and accessories and/or subsequent restoration:
1831, Robert Clark, Jr., Deputy Surveyor
 Set Quarter Section Post
 Beech 13" N53°E 45 links
 Beech 12" N25°W 25 links
 June 10, 1985, Thomas Mueller, #25861. Liber 582, Page 699
 Corner not shown on survey
 February 7, 1990, W.G. Tingley, #30104, Survey
 Found 1" Iron Pipe
 Centerline of Road - South 1.8 feet
 Set nail Eastside Apple 24" N8°W 47.82 feet
 North End Fence to South S60°E 101.0 feet

ACCEPTED BY THE MONTCALM COUNTY SURVEY PEER GROUP AS THE OFFICIAL CORNER UNDER MICHIGAN PUBLIC ACT 345 OF 1990 AT A MEETING HELD 4-14-95

WGT
 William Tingley, PS, Chairman

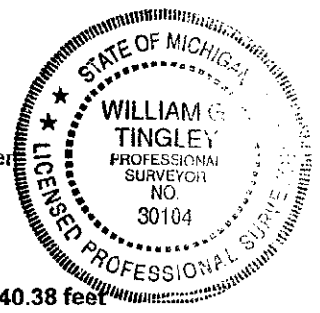

B. Description of corner evidence found and/or method applied in restoring or reestablishing corner:
 Found 1" Pipe in monument box 1.5 feet East of old barb and woven wire fence North.
 1.5 feet North of Centerline of pavement.
 Found Nail Eastside Apple 24" N08°W 47.82 feet
 Found nail in fence to South S60°E 101.0 feet
 Corner is close to mid-point between Southeast and Southwest Corners. Distances being 2640.38 feet and 2640.77 feet respectively.

C. Description of monument for corner and accessories established to perpetuate locating the position of the corner:
 Set Remonumentation Corner in Monument Box over 1" Iron Pipe
 Nail in Eastside Apple 24" N08°W 47.82 feet
 Nail in North end of fence to South S60°E 101.0 feet
 Nail in Northeast side Power Pole N60°W 106.52 feet
 Capped Iron North 33.1 feet

This corner is accepted as a careful and faithful perpetuation of the position of the original corner.

Signed by William Tingley Date 19AUG 95

Surveyor's Michigan License No. 30104

FORM APPROVED BY MICHIGAN STATE BOARD OF LAND SURVEYORS, JAN. 28, 1971
 REVISED MAY 14, 1975
 REVISED JAN., 1983
 ADAPTED FOR WORD PROCESSING MARCH, 1993