

**SURVEY & REMONUMENTATION**

**FEB 19 1999**

**MONTCALM COUNTY REMONUMENTATION PROGRAM**

**LAND CORNER RECORDATION CERTIFICATE**

Filing Requirement of Act 74, Mich. P.A. 1970

**SECTION**

For corners in Montcalm (County)	Located in:	Corner Code #
1. Public Land Survey	Sec 6 T 11N R 7W	B-3, S 1/4
	T R	
	T R	
	T R	
2. Property Controlling in Section	S T R	
	S T R	
3. Miscellaneous Property in Sec.	S T R	
	S T R	

STATE OF MICHIGAN  
MONTCALM COUNTY  
RECORDED

17 DEC 1998 2:15:30 PM

LORI A. WILSON  
REGISTER OF DEEDS

Register of Deeds Stamp & File Number

4. Lot No. \_\_\_\_\_, Recorded Plat \_\_\_\_\_  
5. Private Claims \_\_\_\_\_

	A	B	C	D	E	F	G	H	I	J	K	L	M
1													
2	6	5	4	3	2	1							
3													
4	7	8	9	10	11	12							
5													
6	18	17	16	15	14	13							
7													
8	19	20	21	22	23	24							
9													
10	30	29	28	27	26	25							
11													
12	31	32	33	34	35	36							
13													

I, William Tingley a field survey on May 26, 1994 do hereby certify that under requirements of P.A. 74, Michigan P.A. of 1970, the corner points mentioned in lines 1 and 2 above were in conformance with regulations and rules therefore as required in the current manual of survey instructions of the United States Department of the Interior, Bureau of Land Management or by a decree of a Court of Law and/or that the corner points mentioned in lines 3, 4 and 5 above were in conformance with the rules of the Michigan Board of Land Surveyors or by a Decree of a Court of Law; established, re-established, monumented, re-monumented, recovered, found as expressed below:


NOTE: Not more than 2 corners, all in the same town and range, may be recorded on this certificate.

A. Description of original monument and accessories and/or subsequent restoration:  
 April 1839, Noah Brookfield, Deputy Surveyor, GLO Notes  
 Set Post  
 Beech 10" S30°E 17 links  
 Beech 6" S34°E 19 links  
 1880, Hand Notes 11-7, H.M. Caulkin from R.D. McNutt's files  
 Beech 18" N21-1/2°W 45 links  
 Broken Fire Clay Mon.  
 1884, F.A. Palmer, Field Book 11-7, Page 30  
 Found: Bearing Tree, Beech, N03°W 15 links  
 Fire Clay Mon, Blacksmith Cinders  
 J.F. Daoust, Field Book 11-7, Page 18  
 Found: Bearing Tree living with marks plain, Beech N03°W 15 links  
 New Bearing Tree: Beech 18" N29-1/2°W 45 links  
 Fire Clay Mon, Blacksmith Cinders  
 April 1906, J.F. Daoust, Field Book 11-7, Page 42  
 Found: Mon and Cinders  
 Drove: Gas Pipe by side of Mon and set stones around them  
 April 1906, J.F. Daoust, Recorded Survey, Book 2, Page 200  
 Found: Mon and Cinders  
 Drove: Gas Pipe by side of Mon and set stones around them  
 February 22, 1985, Burt Wickham, #17639, Liber 2, Page 131  
 Found 3/4" Iron in Centerline of East-West Blacktop Road  
 Spike in East side of Power Pole S40°E 45.12 feet  
 Spike in East side of Power Pole N45°E 49.82 feet  
 Spike in East side of Power Pole South 77.10 feet

ACCEPTED BY THE MONTCALM COUNTY SURVEY PEER GROUP AS THE OFFICIAL CORNER UNDER MICHIGAN PUBLIC ACT 345 OF 1990 AT A MEETING HELD 3/14/98.

WGT  
William Tingley, PS, Chairman

Liber 4 Page 49

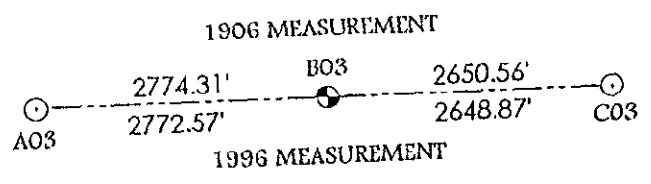

B. Description of corner evidence found and/or method applied in restoring or reestablishing corner:  
 Found 3/4 Iron Rod. Match Burt Wickham witnesses from LCRC recorded Liber 2, Page 131.  
 Dug below Iron Rod. No evidence of gas pipe/fire clay monument  
 Road has been cut 2-3 feet from surrounding area. Agrees closely with County Surveyor.

C. Description of monument for corner and accessories established to perpetuate locating the position of the corner:  
 Set Remonumentation in monument box.  
 Top center 12" Concrete culvert S12°W 23.85 feet  
 Spike in East side Power Pole S40°E 45.12 feet  
 Spike in East side Power Pole N45°E 49.82 feet  
 Spike in East side Power Pole South 77.10 feet  
 Located in Centerline of Road



This corner is accepted as a careful and faithful perpetuation of the position of the original corner.  
 Signed by William Tingley Date 4/16/1998

Surveyor's Michigan License No. 30104