

**SURVEY &  
REMONUMENTATION**

**SEP 1 2 1995** **MONTCALM COUNTY REMONUMENTATION PROGRAM**  
**LAND CORNER RECORDATION CERTIFICATE**  
**COMMISSION Filing Requirement of Act 74, Mich. P.A. 1970**

For corners in Montcalm Located In: \_\_\_\_\_ Corner Code # \_\_\_\_\_  
(County)

1. Public Land Survey Sec 8 T 11 R 7 C-4, W 1/4  
T \_\_\_\_\_ R \_\_\_\_\_  
T \_\_\_\_\_ R \_\_\_\_\_  
T \_\_\_\_\_ R \_\_\_\_\_

2. Property Controlling S \_\_\_\_\_ T \_\_\_\_\_ R \_\_\_\_\_  
in Section S \_\_\_\_\_ T \_\_\_\_\_ R \_\_\_\_\_

3. Miscellaneous S \_\_\_\_\_ T \_\_\_\_\_ R \_\_\_\_\_  
Property in Sec. S \_\_\_\_\_ T \_\_\_\_\_ R \_\_\_\_\_

4. Lot No. \_\_\_\_\_ Recorded Plat \_\_\_\_\_

5. Private Claims \_\_\_\_\_

STATE OF MICHIGAN  
MONTCALM COUNTY  
RECORDED

10 AUG 95 3:35 P.M.

VIRGINIA L. KNEPPER  
REGISTER OF DEEDS

Register of Deeds Stamp & File Number

I, William Tingley a field survey on November 14, 1994

do hereby certify that under requirements of P.A. 74, Michigan P.A. of 1970, the corner points mentioned in lines 1 and 2 above were in conformance with regulations and rules therefore as required in the current manual of survey instructions of the United States Department of the Interior, Bureau of Land Management or by a decree of a Court of Law and/or that the corner points mentioned in lines 3, 4 and 5 above were in conformance with the rules of the Michigan Board of Land Surveyors or by a Decree of a Court of Law; established, re-established, monumented, re-monumented, recovered, found as expressed below:

**NOTE: Not more than 4 corners, all in the same town and range, may be recorded on this certificate.**

**A. Description of original monument and accessories and/or subsequent restoration:**

- April 1, 1839, Noah Brookfield, Deputy Surveyor, GLO notes  
Set Post  
Beech 10"  
November 1869 from R.D. McNutt's Index Cards (11-7 (38)  
New Bearing Tree: Pine 30" N77-1/2°W 42 links  
1884, F.A. Palmer, Field Notes, Page 38  
Found stake  
New Bearing Tree: Pine Stump 40" N82-1/2°E 15-1/2 links  
Fire Clay Mon and pebbles
- April 1906, J.F. Daoust, County Surveyor, Field Notes, Page 42  
Found Mon  
New Bearing Tree: Maple 7" S42-1/2W 98-1/2 links  
Maple 6" N60°W 93-1/2 links
- March 24, 1987, Burt Wickham, Jr., #17639, LCRC, Liber 2, Page 147  
Set R.R. Spike 1.8 feet East of Centerline  
North end 12" Culvert S85°W 24.4 feet  
Set Nail in 30" Maple N45°E 60.7 feet  
Set Nail in 28" Maple S35°W 74.4 feet

ACCEPTED BY THE MONTCALM COUNTY SURVEY PEER GROUP AS THE OFFICIAL CORNER UNDER MICHIGAN PUBLIC ACT 345 OF 1990 AT A MEETING HELD 4-15-95


WGT  
William Tingley, PS, Chairman

	A	B	C	D	E	F	G	H	I	J	K	L	M
1													
2	6	5	4	3	2	1							
3													
4	7	8	9	10	11	12							
5													
6	18	17	16	15	14	13							
7													
8	19	20	21	22	23	24							
9													
10	30	29	28	27	26	25							
11													
12	31	32	33	34	35	36							
13													

Continued on back

**B. Description of corner evidence found and/or method applied in restoring or reestablishing corner:**

- Found fence post 2.3' long, below black top
- Found fire clay mon
- Found square headed bolt driven along side fire clay mon
- Found stones and crockery surrounding fire clay mon
- Found railroad spike North 10.3 feet East 1.8 feet
- Found nail 36" Maple S40°W 65.33 feet
- Found pump N75°W 40.80 feet
- Found nail power pole S40°E 48.10 feet
- Found nail 36" Maple N45°W 65.52 feet

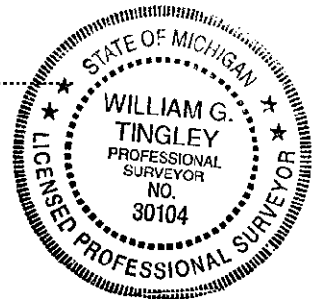

**C. Description of monument for corner and accessories established to perpetuate locating the position of the corner:**

- Set Remonumentation Corner and Monument Box over Fire Clay Monument
- Railroad Spike N10°E 10.46 feet
- Found Nail 36" Maple S40°W 65.33 feet
- Found Pump N75°W 40.80 feet
- Found Nail Power Pole S40°E 48.10 feet
- Found Nail 36" Maple N45°W 65.52 feet

This corner is accepted as a careful and faithful perpetuation of the position of the original corner.

Signed by William Tingley Date 15 APR 1994

Surveyor's Michigan License No. 30104

A. Continued from front (C-4, 11-7)

Montcalm County Road Commission files

Power Pole	East	61.5 feet
36" Maple	Southwest	64.20 feet
Pump	Northwest	40.60 feet
South end of culvert	Southwest	28.20 feet
North end of culvert	Northwest	23.20 feet