

**SURVEY & REMONUMENTATION**

**FEB 19 1998**

**MONTCALM COUNTY REMONUMENTATION PROGRAM**

**LAND CORNER RECORDATION CERTIFICATE**

Filing Requirement of Act 74, Mich. P.A. 1970

STATE OF MICHIGAN  
MONTCALM COUNTY  
RECORDED  
26 Dec 1997 3:37:34 PM  
LORI A. WILSON  
REGISTER OF DEEDS

**SECTION**

For corners in

Located in:

Corner Code #

(County)

**DOUGLASS Township**

1. Public Land Survey	T	11N	R	7W	F-11
	T		R		
	T		R		
	T		R		
2. Property Controlling in Section	S		T	R	
	S		T	R	
3. Miscellaneous Property in Sec.	S		T	R	
	S		T	R	

Register of Deeds Stamp & File Number

4. Lot No. \_\_\_\_\_, Recorded Plat \_\_\_\_\_  
5. Private Claims \_\_\_\_\_

	A	B	C	D	E	F	G	H	I	J	K	L	M
1													
2	6	5	4	3	2								
3													
4	7	8	9	10	11	12							
5													
6	18	17	16	15	14	13							
7													
8	19	20	21	22	23	24							
9													
10	30	29	28	27	26	25							
11													
12	31	32	33	34	35	36							
13													

I, William G. Tingley, in a field survey on JUNE 4TH 19 97, do hereby certify that under requirements of P.A. 74, Michigan P.A. of 1970, the corner points mentioned in lines 1 and 2 above were in conformance with regulations and rules therefore as required in the current manual of survey instructions of the United States Department of the Interior, Bureau of Land Management or by a decree of a Court of Law and/or that the corner points mentioned in lines 3, 4 and 5 above were in conformance with the rules of the Michigan Board of Land Surveyors or by a Decree of a Court of Law; established, re-established, monumented, re-monumented, recovered, found as expressed below:

NOTE: Not more than 4 corners, all in the same town and range, may be recorded on this certificate.

A. Description of original monument and accessories and/or subsequent restoration:  
June 1839, Noah Brookfield, Deputy Surveyor, GLO notes.

- West corrected Between Section 28 and 33
- 39.97 set 1/4 section post
- 10" Black Oak N29°W 23 Links
- 14" Beech S75°W 36 Links

January 1888, H. M. Caulkin, County Surveyor for Montcalm County, Record of Survey, Liber 1, Page 417  
Found Fire Clay Monument put down in 1887, also the N.B.T.s

- June 8th, 1934, R.D.McNutt, Card files
- 1/4 Post 28 and 33
- 10" Black Oak N29°W 23 Links
- 14" Beech S75°W 36 Links
- Found Bearing tree Beech S75°W 36 Links (Green and Thrifty)
- Fire Clay Monument B.S. Clin.
- 1893 N.B.T 38" Pine stump S4 1/2°W 42 Links
- Fireclay Monument
- 6" Oak West 37.0
- 8" Oak Northeast 105.5

ACCEPTED BY THE MONTCALM COUNTY SURVEY PEER GROUP AS THE OFFICIAL CORNER UNDER MICHIGAN PUBLIC ACT 345 OF 1990 AT A MEETING HELD 7-30-97.

WGT.  
William Tingley, PS, Chairman


Continued on back .....

B. Description of corner evidence found and/or method applied in restoring or reestablishing corner:  
Found clay tile 3.4 feet below pavement surface 2 feet north of Kevin Roosien P.K. and tag from All-points surveying.

- Found nail in southwest side power pole N55°W 44.65 Feet
- Street sign post N70°W 31.35 Feet
- Found nail in south side 38" Oak N80°E 106.60 Feet

C. Description of monument for corner and accessories established to perpetuate locating the position of the corner:  
Set remonumentation corner and monument box over clay tile.

- Found nail in southwest side power pole N55°W 44.65 Feet
- Street sign post N70°W 31.35 Feet
- Found nail in south side 38" Oak N80°E 106.60 Feet
- Set nail in southeast side 42" cottonwood. S28°W 191.45 Feet

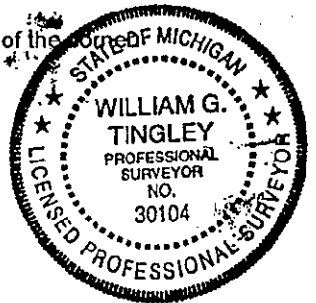

This corner is accepted as a careful and faithful perpetuation of the position of the original corner.

Signed by William G. Tingley Date 2-19-97

Surveyor's Michigan License No. \_\_\_\_\_

FORM APPROVED BY MICHIGAN STATE BOARD OF LAND SURVEYORS, JAN. 28, 1971  
REVISED MAY 14, 1976  
REVISED JAN. 1983  
ADAPTED FOR WORD PROCESSING MARCH 1993

