

SEP 12 1995

COMMISSION

MONTCALM REMONUMENTATION PROGRAM
LAND CORNER RECORDATION CERTIFICATE
Filing Requirement of Act 74, Mich. P.A. 1970

For corners in
Montcalm (County) Located In: Corner Code #

1. Public Land Survey Sec. 36 T 11 R 7 ✓ M-13 SE Cor
31 T 11 R 6 A-73 SW Cor
 T _____
 T _____
 T _____

2. Property Controlling _____
 in Section S _____ T _____ R _____
 S _____ T _____ R _____

3. Miscellaneous _____
 Property in Sec. S _____ T _____ R _____

4. Lot No. _____ Recorded Plat _____
 5. Private Claims _____

STATE OF MICHIGAN
 MONTCALM COUNTY
 RECORDED
 10 AUG 95 3:35 P.M.
 VIRGINIA L. KNEPPER
 REGISTER OF DEEDS
 Register of Deeds Stamp & File Number

1	A	B	C	D	E	F	G	H	I	J	K	L	M
2	6	5	4	3	2	1							
3													
4	7	8	9	10	11	12							
5													
6	18	17	16	15	14	13							
7													
8	19	20	21	22	23	24							
9													
10	30	29	28	27	26	25							
11													
12	31	32	33	34	35	36							
13													

I, William Tingley, a field surveyor on April 3, 1993, do hereby certify that under requirements of P.A. 74, Michigan P.A. of 1970, the corner points mentioned in lines 1 and 2 above were in conformance with regulations and rules therefore as required in the current manual of survey instructions of the United States Department of the Interior, Bureau of Land Management or by a decree of a Court of Law and/or that the corner points mentioned in lines 3, 4 and 5 above were in conformance with the rules of the Michigan Board of Land Surveyors or by a Decree of a Court of Law; established, re-established, monumented, re-monumented, recovered, found as expressed below:

NOTE: Not more than 4 corners, all in the same town and range, may be recorded on this certificate.

- A. Description of original monument and accessories and/or subsequent restoration:
- December 8, 1836, Noah Brookfield, Deputy Surveyor, GLO Notes
 Set Post Corner Towns, 11 North, Range 6 and 7
 Beech 12" N55°E 30 links
 Beech 10" N64°W 65 links
 - 1874, Plat of Turner's Addition, A. Gardner shows distance as 3.17-1/2 chains between North 1/4 Section 1, 10-7 and Township Corner Common to T11N-R6W, and T11N R7W
 - 1875, A. Gardner, Surveyor, Surveyor Book 1, Page 52,
 Northeast Corner House Southwest 1.11 chains
 - R.D. McNutt's, County Surveyor, Index Cards, Gardner, probably 1875
 Iron Pipe 20" long; stones around it
 Northeast Corner of William Turner's house, 111 links; quarter post Northside 1-10-7, East 1.17-12 chains East
 - 1884 H.M. Caulkin, County Surveyor, in Survey of 11-7 Douglass Township Notes
 E1/4 36 & SE Corner 36 in City of Stanton
 - County Road Commission (no date)
 Elm 24" Northeast 71.69 feet
 Northeast Corner House, Southwest 74.34 feet
 Maple 14" Northwest 61.38 feet
 - April 5, 1962, M. Koivisto, Survey Chief, in MCRC Index Cards
 Michigan State Highway Dept: Found axle shaft in monument box
 Catalpa 25" N55°W 48.35 feet
 Maple 25" S45°W 40.14 feet
 Elm 28" S60°E 67.86 feet


ACCEPTED BY THE MONTCALM COUNTY SURVEY PEER GROUP AS THE OFFICIAL CORNER UNDER MICHIGAN PUBLIC ACT 345 OF 1890 AT A MEETING HELD 4-19-95

W. Tingley
 William Tingley, PS, Chalman

Continued on Back

- B. Description of corner evidence found and/or method applied in restoring or reestablishing corner:
- Found monument box with 1" iron bar, Corner Townships 11 North, R 6 and 7 West
 - Found Nail Southside of Power Pole N45°W 49.98 feet
 - Found Nail Westside of Power Pole S40°E 29.65 feet
 - Found Nail & Tag Northside 28" Maple S45°W 39.68 feet
 - Found Nail & Tag Northside Power Pole N60°E 76.23 feet
 - N 1/4 Corner T10N-R7W East 209.5 feet

- C. Description of monument for corner and accessories established to perpetuate locating the position of the corner:
- Set Remonumentation Corner in Monument Box:
 - Found Nail Southside of Power Pole N45°W 49.98 feet
 - Found Nail Westside of Power Pole S40°E 29.65 feet
 - Found Nail & Tag Northside 28" Maple S45°W 39.68 feet
 - Found Nail & Tag Northside Power Pole N60°E 76.23 feet

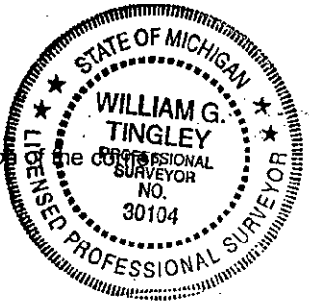

This corner is accepted as a careful and faithful perpetuation of the position of the original corner.

Signed by William Tingley Date April 19, 1995
 Surveyor's Michigan License No. 30104

A. Continued from front (M-13, 11-7)

December 12, 1963, Norman Caldwell #12018, Michigan State Highway Department, MCRC Index
Cards recorded as Southwest
31-11-6

Found 1" iron bar in monument box.

Elm 24"	N45°E	71.69 feet
Northeast corner house foundation	S21°W	74.34 feet
Maple 14"	N34°W	61.38 feet

December 20, 1984, J.S. Fokens #21567, Survey Recorded, Liber 597, Page 25

Found nail in asphalt over monument box

Nail and tag, Dead man	S30°E	39.98'
Nail and tag, Maple	24" Southwest	39.8'
Nail and tag Power Pole	N55°W	50.15'
Nail and tag Power Pole	N55°E	76.1'

April 3, 1993, W.G. Tingley, #30104, Survey

Found Monument Box with Iron Spike

Found Nail South Side Power Pole	N45°W	49.98 feet
Found Nail West Side Power Pole	S40°E	29.65 feet
Found Nail and Tag North Side 28" Maple	S45°W	39.68 feet
Found Nail and Tag North Side Power Pole	N60°E	76.23 feet