


MONTCALM COUNTY REMONUMENTATION PROGRAM
LAND CORNER RECORDATION CERTIFICATE
 Filing Requirement of Act 74, Mich. P.A. 1970

DEC 19 2000

SECTION

For corners in Montcalm Located in: Maple Valley Township Corner Code # C-13
(County)

1. Public Land Survey	Sec. 31,32 T <u>11N</u> R <u>09W</u>	<u>C-13</u>
	T _____ R _____	_____
	T _____ R _____	_____
	T _____ R _____	_____
2. Property Controlling in Section	S _____ T _____ R _____	_____
	S _____ T _____ R _____	_____
3. Miscellaneous Property in Sec.	S _____ T _____ R _____	_____
	S _____ T _____ R _____	_____
4. Lot No. _____	Recorded Plat _____	
5. Private Claims _____		

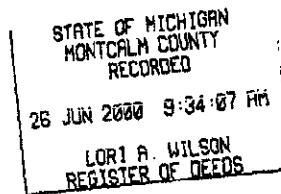

Register of Deeds Stamp & File Number

1	A	B	C	D	E	F	G	H	I	J	K	L	M
2	6	5	4	3	2	1							
3													
4	7	8	9	10	11	12							
5													
6	18	17	16	15	14	13							
7													
8	19	20	21	22	23	24							
9													
10	30	29	28	27	26	25							
11													
12	31	32	33	34	35	36							
13													

I, William G. Tingley, in a field survey on May 02, 2000, do hereby certify that under requirements of P.A. 74, Michigan P.A. of 1970, the corner points mentioned in lines 1 and 2 above were in conformance with regulations and rules therefore as required in the current manual of survey instructions of the United States Department of the Interior, Bureau of Land Management or by a decree of a Court of Law and/or that the corner points mentioned in lines 3, 4 and 5 above were in conformance with the rules of the Michigan Board of Land Surveyors or by a Decree of a Court of Law, established, re-established, monumented, re-monumented, recovered, found as expressed below:

NOTE: Not more than 2 corners, all in the same town and range, may be recorded on this certificate.

- A. Description of original monument and accessories and/or subsequent restoration:
- December 11, 1836, Noah Brookfield, Deputy Surveyor, GLO notes, West on South side Section 32
 Set post corner of Sections 31 and 32
 Beech 10" N78°W 25 links (16.50 feet)
 Beech 10" N19°E 20 links (13.20 feet)
 - July 1895, Henry M. Caukin, County Surveyor, Record of Survey Book 2-A Page 44
 At SE corner of section, found corner as established by E.H. Jones at or about 1892. His NBT pine stump 32" N53°W 25 links (16.50 feet). Put down piece of iron grate bar 16" long.
 - 1989, William R. Byl # 23502, Survey 22-Mile Road Right of Way for MI Bell Telephone Company
 Found "T" iron
 No witnesses given

ACCEPTED BY THE MONTCALM COUNTY SURVEY PEER BOARD AS THE OFFICIAL CORNER UNDER MICHIGAN PUBLIC ACT 345 OF 1990 AT A MEETING HELD 6/14/00


WGT
 William Tingley, PS, Chairman

- B. Description of corner evidence found and/or method applied in restoring or reestablishing corner:
 Searched in the apparent location of the corner. Excavated 3.00 feet x 3.00 feet x 3.00 feet deep. Found "T" iron at 0.3' below surface. The iron was 1.50 feet long. At 1.30 feet was iron grate 17" long. There was evidence of wood along side grate.

- C. Description of monument for corner and accessories established to perpetuate locating the position of the corner:
 Set remonumentation pipe in place of "T" iron. Set iron grate on NE side and "T" iron on south side of pipe
- | | | |
|---------------------------|-------|------------|
| Set N/T E/S 17" elm | S05°W | 19.40 feet |
| Set N/T N/S 48" twin elm | S64°E | 53.55 feet |
| Set N/T E/S 9" elm | N48°E | 16.62 feet |
| Set N/T NE/S 18" twin elm | N61°W | 30.19 feet |

This corner is accepted as the careful and faithful perpetuation of the position of the original corner.

Bearings given are magnetic. Standard remonumentation pipe consists of a Berntsen stainless steel 2 3/8" x 3/8" cap stamped "MONTCALM COUNTY REMONUMENTATION, P.S. # 30104"

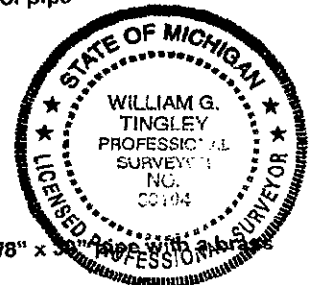

Signed by William G. Tingley Date 6/14/00
 Surveyor's Michigan License No. 30104

FORM APPROVED BY MICHIGAN STATE BOARD OF LAND SURVEYORS, JAN. 28, 1971
 REVISED MAY 14, 1975
 REVISED JAN., 1983
 ADAPTED FOR WORD PROCESSING MARCH, 1993



LIBER 4

PAGE 248