

DEC 19 2000

MONTCALM COUNTY REMONUMENTATION PROGRAM

LAND CORNER RECORDATION CERTIFICATE

Filing Requirement of Act 74, Mich. P.A. 1970


SECTION

For corners in Montcalm (County)

Located In:

Corner Code #

Maple Valley Township

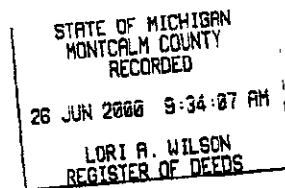

Register of Deeds Stamp & File Number

- 1. Public Land Survey Sec. 33,34 T 11 N R 09 W G-13
2. Property Controlling in Section S T R
3. Miscellaneous Property in Sec. S T R

- 4. Lot No. Recorded Plat
5. Private Claims

I, William G. Tingley, in a field survey on May 02, 2000, do hereby certify that under requirements of P.A. 74, Michigan P.A. of 1970, the corner points mentioned in lines 1 and 2 above were in conformance with regulations and rules therefore as required in the current manual of survey instructions of the United States Department of the Interior, Bureau of Land Management or by a decree of a Court of Law and/or that the corner points mentioned in lines 3, 4 and 5 above were in conformance with the rules of the Michigan Board of Land Surveyors or by a Decree of a Court of Law; established, re-established, monumented, re-monumented, recovered, found as expressed below:

NOTE: Not more than 2 corners, all in the same town and range, may be recorded on this certificate.

Table with 12 columns (A-L) and 12 rows (1-12) containing numbers 1-36 in a grid pattern.

A. Description of original monument and accessories and/or subsequent restoration:

- 1. December 11, 1836, Noah Brookfield, Deputy Surveyor, GLO notes, West on south side section 24
2. December 09, 1899, Henry M. Caukins, County Surveyor, Record of Minutes of Survey Book 3 Page 006
3. September 16, 1912, E. Duff Youdan, County Surveyor, Record of Survey Book 2-B Page 127
4. George Stevenson's Witness card file # 163 at Tingley and Associates office
5. August 26, 1976, Edward J. Glaza # 9548, Certificate of Survey Liber 497 Page 915
6. 1989, William R. Byl, # 23502, Survey of 22-Mile road Right of Way for MI Bell cable placement

ACCEPTED BY THE MONTCALM COUNTY SURVEY PERS. GROUP AS THE OFFICIAL CORNER UNDER MICHIGAN PUBLIC ACT 345 OF 1990 AT A MEETING HELD 6/14/00


B. Description of corner evidence found and/or method applied in restoring or reestablishing corner: Found R.R. spike inside 1 1/2" iron pipe. Along the west side of iron pipe was a plow point. Excavated 2.5 feet, no other evidence found.

C. Description of monument for corner and accessories established to perpetuate locating the position of the corner: Set remonumentation pipe over R.R. spike and 1 1/2" iron pipe. Set plow point on west side as originally set. East side "Arrow" sign S04°W 24.73 feet, Center east side cable marker N49°W 31.15 feet, Center west side cable marker N35°E 56.00 feet, Set N/T E/S power pole N08°W 107.16 feet

This corner is accepted as the careful and faithful perpetuation of the position of the original corner.

Bearings given are magnetic. Standard remonumentation pipe consists of a Bernlsen stainless steel 2 3/8" x 30" pipe with a brass cap stamped "MONTCALM COUNTY REMONUMENTATION, P.S. # 30104"

Signed by William G. Tingley Date 6/14/00 Surveyor's Michigan License No. 30104

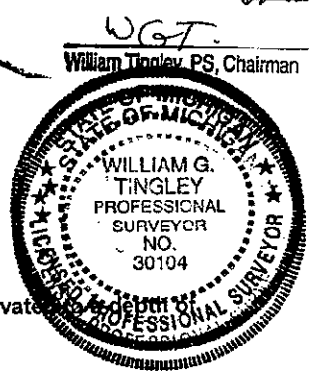

LIBER 4 PAGE 246