

**SURVEYOR
REMONUMENTATION**

SEP 1 8 1995

COMMISSION

**MONTCALM REMONUMENTATION PROGRAM
LAND CORNER RECORDATION CERTIFICATE
Filing Requirement of Act 74, Mich. P.A. 1970**

For corners in Montcalm Located In: _____ Corner Code # _____
(County)

1. Public Land Survey Sec. 36 T 11 R 7 M-13, SE Cor
~~T 11 R 6 M-13, SW Cor~~
T _____ R _____
T _____ R _____

2. Property Controlling S _____ T _____ R _____
in Section S _____ T _____ R _____

3. Miscellaneous S _____ T _____ R _____
Property in Sec. S _____ T _____ R _____

4. Lot No. _____, Recorded Plat _____

5. Private Claims _____

STATE OF MICHIGAN
MONTCALM COUNTY
RECORDED

10 AUG 95 3:35 P.M.

VIRGINIA L. KNEPPER
REGISTER OF DEEDS

Register of Deeds Stamp & File Number

I, William Tingley a field survey on April 3, 1993, do hereby certify that under requirements of P.A. 74, Michigan P.A. of 1970, the corner points mentioned in lines 1 and 2 above were in conformance with regulations and rules therefore as required in the current manual of survey instructions of the United States Department of the Interior, Bureau of Land Management or by a decree of a Court of Law and/or that the corner points mentioned in lines 3, 4 and 5 above were in conformance with the rules of the Michigan Board of Land Surveyors or by a Decree of a Court of Law; established, re-established, monumented, re-monumented, recovered, found as expressed below:

A	B	C	D	E	F	G	H	I	J	K	L	M
6	5	4	3	2	1							
7	8	9	10	11	12							
18	17	16	15	14	13							
19	20	21	22	23	24							
30	29	28	27	26	25							
31	32	33	34	35	36							

NOTE: Not more than 4 corners, all in the same town and range, may be recorded on this certificate.

A. Description of original monument and accessories and/or subsequent restoration:
December 8, 1836, Noah Brookfield, Deputy Surveyor, GLO Notes
Set Post Corner Towns, 11 North, Range 6 and 7
Beech 12" N55°E 30 links
Beech 10" N64°W 65 links
1874, Plat of Turner's Addition, A. Gardner shows distance as 3.17-1/2 chains between North 1/4 Section 1, 10-7 and Township Corner Common to T11N-R6W, and T11N R7W
1875, A. Gardner, Surveyor, Surveyor Book 1, Page 52,
Northeast Corner House Southwest 1.11 chains
R.D. McNutt's, County Surveyor, Index Cards, Gardner, probably 1875
Iron Pipe 20" long; stones around it
Northeast Corner of William Turner's house, 111 links; quarter post Northside 1-10-7, East 1.17-12 chains East
1884 H.M. Caulkin, County Surveyor, in Survey of 11-7 Douglass Township Notes E1/4 36 & SE Corner 36 in City of Stanton
County Road Commission (no date)
Elm 24" Northeast 71.69 feet
Northeast Corner House, Southwest 74.34 feet
Maple 14" Northwest 61.38 feet
April 5, 1962, M. Koivisto, Survey Chief, in MCRC Index Cards
Michigan State Highway Dept: Found axle shaft in monument box
Catalpa 25" N55°W 48.35 feet
Maple 25" S45°W 40.14 feet
Elm 28" S60°E 67.86 feet


ACCEPTED BY THE MONTCALM COUNTY SURVEY PEER GROUP AS THE OFFICIAL CORNER UNDER MICHIGAN PUBLIC ACT 345 OF 1890 AT A MEETING HELD 7-19-95

W. Tingley
William Tingley, PS, Chairman

Continued on Back

B. Description of corner evidence found and/or method applied in restoring or reestablishing corner:
Found monument box with 1" iron bar, Corner Townships 11 North, R 6 and 7 West
Found Nail Southside of Power Pole N45°W 49.98 feet
Found Nail Westside of Power Pole S40°E 29.65 feet
Found Nail & Tag Northside 28" Maple S45°W 39.68 feet
Found Nail & Tag Northside Power Pole N60°E 76.23 feet
N 1/4 Corner T10N-R7W East 209.5 feet

C. Description of monument for corner and accessories established to perpetuate locating the position of the corner:
Set Remonumentation Corner in Monument Box
Found Nail Southside of Power Pole N45°W 49.98 feet
Found Nail Westside of Power Pole S40°E 29.65 feet
Found Nail & Tag Northside 28" Maple S45°W 39.68 feet
Found Nail & Tag Northside Power Pole N60°E 76.23 feet

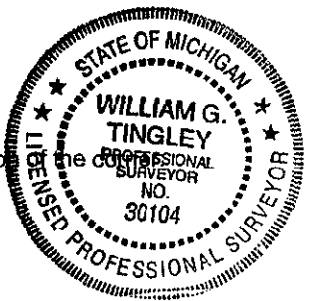

This corner is accepted as a careful and faithful perpetuation of the position of the original corner.
Signed by William Tingley Date April 19, 1995
Surveyor's Michigan License No. 30104

FORM APPROVED BY MICHIGAN STATE BOARD OF LAND SURVEYORS, JAN. 28, 1971
REVISED MAY 14, 1976
REVISED JAN., 1983
ADAPTED FOR WORD PROCESSING MARCH, 1993