

APR 28 1999

MONTCALM COUNTY REMONUMENTATION PROGRAM

LAND CORNER RECORDATION CERTIFICATE

Filing Requirement of Act 74, Mich. P.A. 1970

SECTION

For corners in Montcalm (County)	Located in:	Corner Code #
	Day Township	
1. Public Land Survey	Sec T <u>11N</u> R <u>6 W</u>	<u>C-8, 1/4 Corner</u>
	T _____ R _____	_____
	T _____ R _____	_____
	T _____ R _____	_____
2. Property Controlling in Section	S _____ T _____ R _____	_____
	S _____ T _____ R _____	_____
3. Miscellaneous Property in Sec.	S _____ T _____ R _____	_____
	S _____ T _____ R _____	_____

STATE OF MICHIGAN
MONTCALM COUNTY
RECORDED
17 DEC 1998 2:10:44 PM
LORI A. WILSON
REGISTER OF DEEDS

Register of Deeds Stamp # _____ File Number _____

4. Lot No. _____, Recorded Plat _____
5. Private Claims _____

	A	B	C	D	E	F	G	H	I	J	K	L	M
1													
2	6		5		4		3		2		1		
3													
4	7		8		9		10		11		12		
5													
6	18		17		16		15		14		13		
7													
8	19	20	21	22	23	24							
9													
10	30	29	28	27	26	25							
11													
12	31	32	33	34	35	36							
13													

I, William Tingley a field survey on October 9, 1996, do hereby certify that under requirements of P.A. 74, Michigan P.A. of 1970, the corner points mentioned in lines 1 and 2 above were in conformance with regulations and rules therefore as required in the current manual of survey instructions of the United States Department of the Interior, Bureau of Land Management or by a decree of a Court of Law and/or that the corner points mentioned in lines 3, 4 and 5 above were in conformance with the rules of the Michigan Board of Land Surveyors or by a Decree of a Court of Law; established, re-established, monumented, re-monumented, recovered, found as expressed below:

NOTE: Not more than 2 corners, all in the same town and range, may be recorded on this certificate.

A. Description of original monument and accessories and/or subsequent restoration:
1837, John Milroy, Deputy Surveyor, GLO Notes

- Set Quarter Section Post
- Birch 18" S60°W 11 links
- Beech 14" N64°E 28 links

1875, A. F. Gardner, Surveyor, Liber 1, Page 43, Record of Minutes of Survey
Ran the two quarter lines of said section. Found trees of old corner on East side badly decayed and made new bearing trees as follows:

- Beech 6" S75°E 7 links
- Ironwood N25°W 6 links

1896, Henry Caukin, County Surveyor, Liber 2, Page 50, Record of Minutes of Survey
Shows 1/4 Corner 2628.12 feet North of C-9
1979, D. Whittier #10070, LCRC, Liber 1, Page 155
Found 3" Solid Clay Tile with stones around.

ACCEPTED BY THE MONTCALM COUNTY SURVEY PEER GROUP AS THE OFFICIAL CORNER UNDER MICHIGAN PUBLIC ACT 345 OF 1990 AT A MEETING HELD 4/15/98


WST
William Tingley, PS, Chairman

- Set 3/4" Pipe under tile.
- Centerline 30" Oak N30°W 75.1 feet
- Nail in East Side Power Pole S45°E 60.25 feet
- Nail in East Side Power Pole S45°W 71.90 feet

B. Description of corner evidence found and/or method applied in restoring or reestablishing corner:
Found 3/4" Iron Pipe under 3" solid clay tile 0.7 feet below surface of gravel 1 foot West of Centerline Peoples Road and 3 feet North of Centerline Hillis Road.

C. Description of monument for corner and accessories established to perpetuate locating the position of the corner:
Set Remonumentation Monument over Pipe.

- Found Nail Northeast Face Power Pole S33°E 60.07 feet
- Found Nail Southeast Face Power Pole S47°W 71.90 feet
- Set Nail and Tag Northwest Face Power Pole N26°E 84.59 feet
- Set Nail and Tag Southwest Face 32" White Oak N21°W 75.10 feet

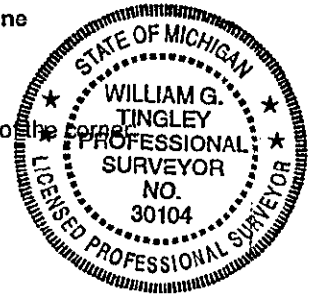

This corner is accepted as the best available evidence of the position of the original corner.

Signed by William Tingley Date 4/15/98 1998
Surveyor's Michigan License No. 30104

FORM APPROVED BY MICHIGAN STATE BOARD OF LAND SURVEYORS, JAN. 28, 1971
REVISED MAY 14, 1978
REVISED JAN., 1983

ADAPTED FOR WORD PROCESSING MARCH, 1993

FEB 19 1999

SECTION

307