

**SURVEY &
MONUMENTATION**

MONTCALM COUNTY REMONUMENTATION PROGRAM

JAN 17 1996

LAND CORNER RECORDATION CERTIFICATE

COMMISSION

Filing Requirement of Act 74, Mich. P.A. 1970

For corners in Montcalm Located in: _____ Corner Code # _____
 (County) Day Township _____

1. Public Land Survey Sec. 31 T 11 N R 6 W C-13 S Bndry.
 and 32 T _____ R _____
 T _____ R _____
 T _____ R _____

2. Property Controlling S _____ T _____ R _____
 in Section S _____ T _____ R _____

3. Miscellaneous S _____ T _____ R _____
 Property in Sec. S _____ T _____ R _____

4. Lot No. _____, Recorded Plat _____

5. Private Claims _____

STATE OF MICHIGAN
MONTCALM COUNTY
RECORDED

20 DEC 95 11:39 A.M.

VIRGINIA L. KNEPPER
REGISTER OF DEEDS

Register of Deeds Stamp & File Number

	A	B	C	D	E	F	G	H	I	J	K	L	M
1													
2	6	5	4	3	2	1							
3													
4	7	8	9	10	11	12							
5													
6	18	17	16	15	14	13							
7													
8	19	20	21	22	23	24							
9													
10	30	29	28	27	26	25							
11													
12	31	32	33	34	35	36							
13													

I, William Tingley a field surveyor on March 9, 1995, do hereby certify that under requirements of P.A. 74, Michigan P.A. of 1970, the corner points mentioned in lines 1 and 2 above were in conformance with regulations and rules therefore as required in the current manual of survey instructions of the United States Department of the Interior, Bureau of Land Management or by a decree of a Court of Law and/or that the corner points mentioned in lines 3, 4 and 5 above were in conformance with the rules of the Michigan Board of Land Surveyors or by a Decree of a Court of Law; established, re-established, monumented, re-monumented, recovered, found as expressed below:


NOTE: Not more than 4 corners, all in the same town and range, may be recorded on this certificate.

A. Description of original monument and accessories and/or subsequent restoration:
December 1836, Noah Brookfield, Deputy Surveyor, GLO Notes

- Set Post
 - Beech 10" N70°W 28 links
 - Beech 10" N77°E 73 links
- 1923 MCH (on R.D. McNutt's index cards)
 - Ford Axle
 - Notch in Stumps N75°W 41.6 feet
 - Notch in Stumps N45°E 34.7 feet
- 1925, Michigan State Highway Department
 - Found Gas Pipe 7.8 feet North of Centerline
 - Notch in Stump Fence N75°W 41.6 feet
 - Notch in Stump Fence N45°E 34.7 feet
- Montcalm County Road Commission, index cards -- No date
 - Found Steel Shaft, brought to surface with wood stake
 - Maple 15" Northeast 65.2 feet
 - Power Pole Southwest 78.8 feet
- 1963, Norm Caldwell, Michigan State Highway Department
 - Power Pole S20°W 69.07 feet
 - Hydrant N45°W 54.75 feet
 - Telephone Pole N30°W 51.60 feet
 - Railroad Spike East 135.35 feet

ACCEPTED BY THE MONTCALM COUNTY SURVEY PEER GROUP AS THE OFFICIAL CORNER UNDER MICHIGAN PUBLIC ACT 345 OF 1990 AT A MEETING HELD 12-5-95

WGT
 William Tingley, PS, Chairman

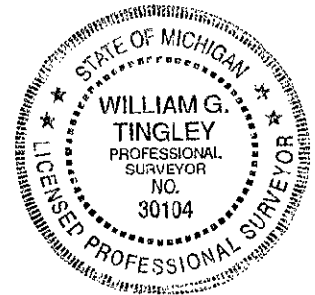

Centerline Stanton and Peoples Roads 1.3 feet South of Centerline

- February 25, 1991, David R. Lohr, #33090, Survey
 - Found Railroad Spike Peoples and Stanton Road
 - Found Railroad Spike East 135.35 feet
 - Set Nail and Tag in Pole S20°W 69.07 feet
 - Centerline of Hydrant N45°W 54.75 feet
 - Set Nail and Tag in Pole N30°W 51.60 feet

B. Description of corner evidence found and/ or method applied in restoring or reestablishing corner:
 Found rered in Monument Box 9 feet West Centerline Gravel Road North and 134 feet +/- West of fence South

- Found nail in Power Pole S20°W 69.31 feet
- Found Centerline Hydrant N45°W 54.75 feet
- Found Power Pole N30°W 51.60 feet

One Foot south of Centerline Pavement and 9 feet West of Centerline Gravel Road North

C. Description of monument for corner and accessories established to perpetuate locating the position of the corner:

- Set Remonumentation Corner in place of Rered in Monument Box
 - Found Spike in Westside of Power Pole S20°W 69.31 feet
 - Set Spike in Westside of Power Pole N30°W 51.55 feet
 - Centerline of Hydrant N45°W 54.75 feet
 - Southwest Corner of Telephone Box N45°E 59.72 feet

This corner is accepted as a careful and faithful reestablishment of the position of the original corner.

Signed by William B. Tingley Date 12-12-95

Surveyor's Michigan License No. 30104

FORM APPROVED BY MICHIGAN STATE BOARD OF LAND SURVEYORS, JAN. 28, 1971

REVISED MAY 14, 1976

REVISED JAN., 1983

ADAPTED FOR WORD PROCESSING MARCH, 1993