

**SURVEY  
REMONUMENTATION**

SEP 1 8 1995

COMMISSION

**MONTCALM COUNTY REMONUMENTATION PROGRAM**

**LAND CORNER RECORDATION CERTIFICATE**

**Filing Requirement of Act 74, Mich. P.A. 1970**

For corners in  
Montcalm  
(County)

Located In: \_\_\_\_\_ Corner Code # \_\_\_\_\_

1. Public Land Survey Sec 9 T 11 R 6 E-3, NW Corner  
 \_\_\_\_\_  
 T \_\_\_\_\_ R \_\_\_\_\_  
 T \_\_\_\_\_ R \_\_\_\_\_  
 T \_\_\_\_\_ R \_\_\_\_\_

2. Property Controlling S \_\_\_\_\_ T \_\_\_\_\_ R \_\_\_\_\_  
 in Section S \_\_\_\_\_ T \_\_\_\_\_ R \_\_\_\_\_

3. Miscellaneous S \_\_\_\_\_ T \_\_\_\_\_ R \_\_\_\_\_  
 Property in Sec. S \_\_\_\_\_ T \_\_\_\_\_ R \_\_\_\_\_

STATE OF MICHIGAN  
MONTCALM COUNTY  
RECORDED

10 AUG 95 3:32 P.M.

VIRGINIA L. KNEPPER  
REGISTER OF DEEDS  
Register of Deeds Stamp & File Number

4. Lot No. \_\_\_\_\_, Recorded Plat \_\_\_\_\_  
 5. Private Claims \_\_\_\_\_

	A	B	C	D	E	F	G	H	I	J	K	L	M
1													
2	6	5	4	3	2	1							
3													
4	7	8	9	10	11	12							
5													
6	18	17	16	15	14	13							
7													
8	19	20	21	22	23	24							
9													
10	30	29	28	27	26	25							
11													
12	31	32	33	34	35	36							
13													

I, William Tingley a field survey on July 5, 1994  
do hereby certify that under requirements of P.A. 74, Michigan P.A. of 1970, the corner points mentioned in lines 1 and 2 above were in conformance with regulations and rules therefore as required in the current manual of survey instructions of the United States Department of the Interior, Bureau of Land Management or by a decree of a Court of Law and/or that the corner points mentioned in lines 3, 4 and 5 above were in conformance with the rules of the Michigan Board of Land Surveyors or by a Decree of a Court of Law; established, re-established, monumented, re-monumented, recovered, found as expressed below:


**NOTE: Not more than 4 corners, all in the same town and range, may be recorded on this certificate.**

A. Description of original monument and accessories and/or subsequent restoration:  
**1837 John Milroy, Deputy Surveyor, GLO Notes**  
 Set post  
 Beech 13" S35°W 13 links  
 Maple 15" N74°E 26 links  
 Nov. 20, 1905, J.F. Daoust, County Surveyor, County Records Book 2, Page 174  
 Found file  
 Pine stump S31-1/2°E 114.5 links

ACCEPTED BY THE MONTCALM COUNTY SURVEYOR GROUP AS THE OFFICIAL CORNER UNDER MICHIGAN PUBLIC ACT 345 OF 1990 AT A MEETING HELD 19A 22 95  
William Tingley  
 William Tingley, PS, Chairman

B. Description of corner evidence found and/or method applied in restoring or reestablishing corner:  
 Found 3/4" Iron Pipe 6" long above 1" square bar 1.2 feet long above 1" solid bolt 6" long above boat spike 1.2" long.  
 Cedar Stake Southside bolt, 3.6 feet deep. Below cedar stake found Fire Clay Mon (cedar stake had glass around it).

C. Description of monument for corner and accessories established to perpetuate locating the position of the corner:  
**Set Remonumentation Corner and Monument Box over Fire Clay Monument.**  
 Set Nail & Tag, Power Pole N50°W 60.75 feet  
 Set Nail & Tag 20" Oak S30°E 80.00 feet  
 Gas Pipeline marker N85°E 24.7 feet  
 Stop Sign Post S45°W 44.13 feet  
 Located Centerline North-South and West roads

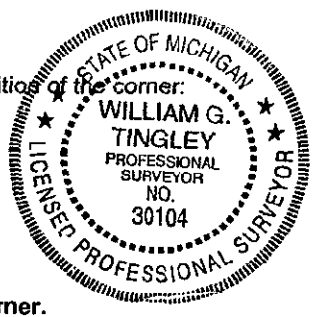

This corner is accepted as a careful and faithful perpetuation of the position of the original corner.

Signed by William G. Tingley Date 19A 22 95, 1994  
 Surveyor's Michigan License No. 30104

FORM APPROVED BY MICHIGAN STATE BOARD OF LAND SURVEYORS, JAN. 28, 1971  
 REVISED MAY 14, 1975  
 REVISED JAN., 1983  
 ADAPTED FOR WORD PROCESSING MARCH, 1993